

MISSISSIPPI DEPARTMENT OF ENVIRONMENTAL QUALITY
Bureau of Land and Water Resources

P. O. Box 10631
Jackson, MS 39289-0631

COUNTY WELL LOCATED
Jackson

WELL NUMBER *G 119* CODED

DATE WELL COMPLETED
04/01 92

PERMIT NUMBER

NAME OF DRILLING FIRM
Coast Water Well, Inc.

WATER WELL DRILLERS LOG

NAME & MAILING ADDRESS OF LANDOWNER
Swayne Scott

WELL LOCATION: SEC *22* TOWNSHIP *5^N* RANGE *6^E*

DISTANCE *3* Miles *S* DIRECTION of *Wade* NEAREST TOWN

OTHER LANDMARK

WELL PURPOSE: Home Irrigation, Municipal, Industrial, Fish Pond, etc.

PUMP DATA

PUMP TYPE (Circle One):
Submersible, Turbine, Jet, Flowing Well,
Other (Describe)

POWER TYPE (Circle One):
Electric, Tractor, Diesel, Gasoline, Butane,
Other (Describe) H/P

Pump Capacity (GPM) _____ No. of Stages _____ Setting Depth _____ FT.

PUMP TEST

Well yielded _____ GPM with
a drawdown of _____ ft.
after _____ hours of pumping

WELL DATA

Well Depth <i>698'</i>	Casing Diameter (In.) <i>2"</i>	Casing Length (Ft.) <i>683'</i>
Type of Casing <i>PVC</i>	Hole Depth <i>698'</i>	Depth to Static Water Level <i>5'</i>

TYPE OF COMPLETION: (Circle One or More):
Gravel Packed, Underreamed, Telescoped,
Natural Development, Open Hole, Other

Top of Lap Pipe or Reduction in Casing

FEET IF TELESCOPED OR MORE THAN ONE SCREEN: USE BACK PAGE

LOG DATA

TYPE OF LOG RUN (Circle One):
Electric, Gamma Ray, Density, Sonic, Neutron,
Other (Describe) No Log Run

Name of Organization Running Log

SCREEN DATA

Diameter - Inches <i>2"</i>	Length - Feet <i>15'</i>	Slot Size - Inches <i>.004</i>
Screen Type <i>wrap PVC</i>	Depth to Bottom - Feet <i>698'</i>	

GEOLOGIC DATA (Office Use Only)

Surface Elev.	Geologic Unit	Unit Thickness	Depth to Top
Subs. SWL	Date	Analysis	Aquifer Test

Driller's Remarks

DESCRIPTION OF FORMATIONS ENCOUNTERED	FROM	TO
<i>yellow clay</i>	<i>0</i>	<i>40</i>
<i>sand + gravel</i>	<i>40</i>	<i>120</i>
<i>blue clay</i>	<i>120</i>	<i>390</i>
<i>sand</i>	<i>390</i>	<i>400</i>
<i>blue clay</i>	<i>400</i>	<i>630</i>
<i>sand</i>	<i>630</i>	<i>698</i>

RECEIVED


OCT 07 1992

Dept. of Environmental Quality
Bureau of Land & Water Resources

IF MORE SPACE IS NEEDED, USE BACK

If well telescopes please sketch and show depths.

GROUND LEVEL

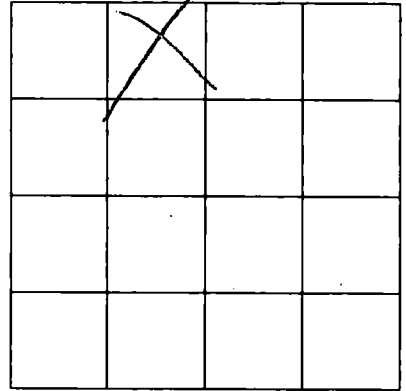


SECTION _____

Please indicate well location X.

ADDITIONAL INFORMATION

Multiple horizontal lines for additional information.

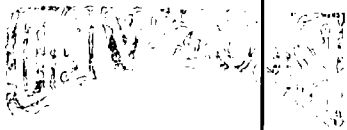

1000 ISHERTON...
2000 1000...

If more than one screen,
show location of each on sketch.