

MISSISSIPPI DEPARTMENT OF ENVIRONMENTAL QUALITY

Office of Land and Water Resources

P. O. Box 10631
Jackson, MS 39289-0631
WATER WELL DRILLERS LOG

COUNTY WELL LOCATED <i>Jackson</i>	
WELL NUMBER <i>128</i>	CODED <input checked="" type="checkbox"/>
DATE WELL COMPLETED <i>10-4-94</i>	

PERMIT NUMBER
NAME OF DRILLING FIRM <i>Coast Water Well Service</i>

NAME & MAILING ADDRESS OF LANDOWNER <i>James Robinson Big Point Rd. Pascagoula, Ms</i>			
WELL LOCATION <i>SW SW</i>	SEC <i>25</i>	TOWNSHIP <i>5 S</i>	RANGE <i>6 E</i>
DISTANCE <i>5</i> Miles	DIRECTION <i>SE</i>	NEAREST TOWN <i>Wade</i>	
OTHER LANDMARK			
WELL PURPOSE <input checked="" type="radio"/> Home, <input type="radio"/> Irrigation, <input type="radio"/> Municipal, <input type="radio"/> Industrial, <input type="radio"/> Fish Pond, etc.			

PUMP DATA		
PUMP TYPE (Circle One): Submersible, Turbine, <input checked="" type="radio"/> Jet, <input type="radio"/> Flowing Well, Other (Describe) _____		
POWER TYPE (Circle One): <input checked="" type="radio"/> Electric, <input type="radio"/> Tractor, <input type="radio"/> Diesel, <input type="radio"/> Gasoline, <input type="radio"/> Butane, Other (Describe) _____ H/P <i>1</i>		
Pump Capacity (GPM) <i>11</i>	No. of Stages <i>2</i>	Setting Depth _____ FT.
PUMP TEST Well yielded _____ GPM with a drawdown of _____ ft. after _____ hours of pumping		

WELL DATA		
Well Depth <i>280'</i>	Casing Diameter (in) <i>2"</i>	Casing Length (Ft) <i>270</i>
Type of Casing <i>PVC</i>	Hole Depth <i>280'</i>	Depth to Static Water Level <i>30'</i>
TYPE OF COMPLETION: (Circle One or More): <input checked="" type="radio"/> Gravel Packed, <input type="radio"/> Underreamed, <input type="radio"/> Telescoped, <input checked="" type="radio"/> Natural Development, <input type="radio"/> Open Hole, <input type="radio"/> Other (Describe) _____		
WELL GROUTED TO A DEPTH OF <i>20</i> FEET Type Grout (circle one): Cement <input checked="" type="radio"/> Bentonite <input type="radio"/> or Mix		

LOG DATA	
TYPE OF LOG RUN (Circle One): Electric, Gamma Ray, Density, Sonic, <input checked="" type="radio"/> Neutron, Other (Describe) _____	
Name of Organization Running Log	

SCREEN DATA		
Diameter - Inches <i>2"</i>	Length - Feet <i>10'</i>	Slot Size - Inches <i>.008'</i>
Screen Type <i>PVC</i>	Depth to Bottom - Feet <i>280'</i>	


GEOLOGIC DATA (Office Use Only)			
Surface Elev.	Geologic Unit	Unit Thickness	Depth to Top
Subs. SWL	Date	Analysis	Aquifer Test
Driller's Remarks			
Top of Lap Pipe or Reduction in Casing			
FEET		IF TELESCOPED OR MORE THAN ONE SCREEN: USE BACK PAGE	

DESCRIPTION OF FORMATIONS ENCOUNTERED	FROM	TO
<i>Top Soil</i>	<i>0</i>	<i>2</i>
<i>Red to Orange clay</i>	<i>2</i>	<i>15</i>
<i>Coarse sand - yellow</i>	<i>15</i>	<i>95</i>
<i>Blue clay - streaky sand</i>	<i>95</i>	<i>140</i>
<i>Coarse sand</i>	<i>140</i>	<i>173</i>
<i>Blue Clay - Rock</i>	<i>173</i>	<i>255</i>
<i>Fine Medial sand</i>	<i>255</i>	<i>280</i>

FORMATIONS (Continued)	FROM	TO
RECEIVED		
NOV 10 1994		
Dept. of Environmental Quality Office of Land & Water Resources		
IF MORE SPACE IS NEEDED USE BACK		

If well telescopes please sketch and show depths.

GROUND LEVEL

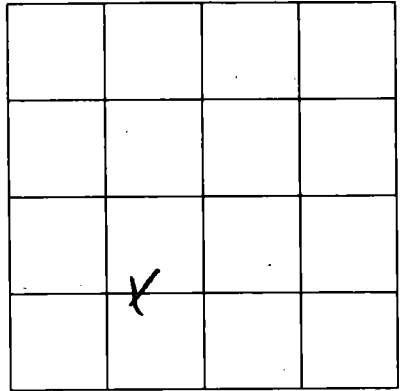

SECTION

25

Please indicate well location X.

ADDITIONAL INFORMATION

RECEIVED

NOV 19 1984

STATE OF TEXAS
DEPARTMENT OF HEALTH
DIVISION OF PUBLIC HEALTH

If more than one screen,
show location of each on sketch.