	State W	Vell Report	
County: Jackson	I	Part 1	For Office Use Only:
Permit #:	Mississippi Departmen	nt of Environmental Quality and Water Resources	Aquifer:
Driller: Michaels Havard	P.O. 1	Box 10631	Well #: G - 188
Date drilling completed: 10 - 12 - 07		AS 39289-0631)961-5210	L. S. Elevation:
		4-6938 (fax)	E-log #:
State Law requires that this rep 30 days of completion of drilling		driller in detail and filed w	ith the Department within
Well Owner Informa		Wel	Location
Owner Name Eric Tillman		Latitude: <u>30 ° 36 '917</u> " Longitude: 88 ° 33 ' 186"	
Mailing Address: 5804 Tillman Street		Method of Lat/Long (circle or	ne): Conventional Survey,
		USGS quad, Hand-held	GPS) Survey-grade GPS
0	20531	1/4 1/4 Sec_14	Twn T55 Rng RLW
<u>Pascagoula n</u> City Stat	$\frac{15}{16} = \frac{39581}{2100000000000000000000000000000000000$	Distance Direction	Nearest Town of Wrac
Telephone No. (228) 762-648	34	$ \underline{3} Miles \underline{3} $	of_Wrde
· · ·	Well	Data	
Purpose of Well (circle one) for Ind			Other
		-	
Date well drilling started: 10.12.			
If flowing, method of flow regulation: Val			
Static Water Level:feet ab	ove or below (circle one)	and surface Date measured:_	10-12-04
Method of Measurement (circle one)	eel tape electric tape	air line other:	· · · · · · · · · · · · · · · · · · ·
Hole depth: <u>70</u> Well dep	oth: <u>70</u>	Well grouted to a depth of	12 feet
Type of grout (circle one): Cement	Bentonite Mix		
Casing length: 60 feet Casin	ng diameter:	inches Type of casing:	NL SYO BE
Screen length: <u>10</u> feet Scree	en diameter:	inches Type of screen:	Jop Puc
Screen slot size:	Setting depth: From _	LO feet to	feet
Type of completion (circle all applicable):	Gravel packed Under	reamed Telescoped Open	hole Natural Development
	Other (describe):		
Top of lap pipe or reduction in casing:		·	
Logs run (circle all applicable): No log run		-	
Name of organization running log(s):			
I certify that the well was drilled, constru	ucted, and completed in a	accordance with all applicable	requirements of the Mississippi
Department of Environmental Quality a	nd/or the Mississippi Dej	partment of Health regulations	and state laws.
Michael S Havaid	0-673	_ plil	l Hd
Print Name of Water Well Contractor and	License No.	Signature of	Water Well Contractor
		REC	CEIVED
		DEC	C 0 3 2007
		RV.	OIWR

-

G-188

If well telescopes please sketch below and show depths.

Ground Level

Signature of

Water

Well Contractor


Description of Formations Encountered	From	То
Top isond Sand	0	5
Sand	5	18
Classi-	18	35
Sind	35	50
(144-	50	55
Sind	55	70
line in the second seco		
		┠───┤
······································		
	_	

RECEIVED

LEU 3 2007

BY: OLWR

If more than one screen, show location of each on sketch

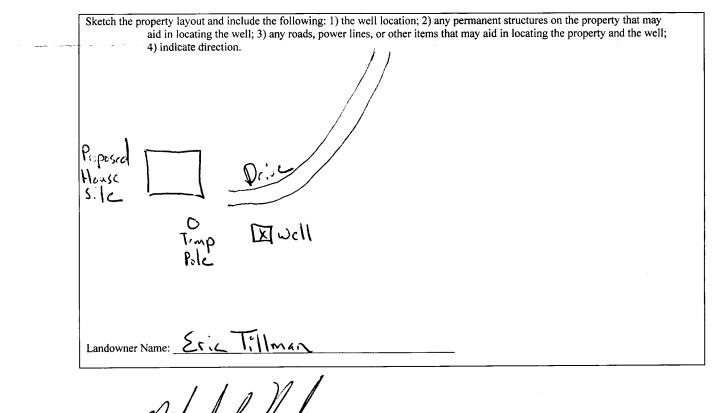

	STATE WELL REPORT	
County: Jackson	Part 2 Pump Installer's Completion Report	For Office Use Only:
Permit #:	Mississippi Department of Environmental Quality Office of Land and Water Resources	Aquifer:
Driller: Michael S. Havaid	P.O. Box 10631 Jackson, MS 39289-0631	Well #: G-188
Date completed: 10 - 12 - 67	(601)961-5210 (601)354-6938 (fax)	Elevation:

This report should be prepared by the pump installer in detail and filed with the Department within 30 days of the

installation of pump.	
Well Owner Information	Well Location
Owner Name: Eric Tillman	Latitude: <u>N 30° 36 917</u> Longitude: <u>W 88° 33, 186</u>
Mailing Address: 5801 Tillman Street	Method of Lat/Long (circle one): Conventional Survey,
	USGS quad, Hand-held GPS, Survey-grade GPS
Pascagoula MS 39581 City State Zip Code	1/4 Sec_14 Twn_ T55 Rng RGW
City State Zip Code	Distance Direction Nearest Town
Telephone No. (228) 762 - 6484	<u></u>
Pump Type Circle one	Power Type Circle one
Air Lift Jet Submersible	Diesel Engine Gasoline Engine Natural Gas
Bucket Piston Turbine	Electric Motor Hand Tractor PTO
Centrifugal Rotary Flowing Well	Windmill Other (specify):
Other (specify):	Horse Power Rating of Motor:
Date Pump Installed: 10-12 07	Setting Depth: 50 feet
Rated Pump Capacity:Gallons Per Minute	Number of Stages:
Pump Test Data	Method of Measuring Water Level
Date Well Tested: 10 - 12 - 67	Circle one
Static Water Level (A): 22 Feet Below Land Surface	Air Line Electric Measuring Line Steel Tape
Pumping Water Level (B): <u>32</u> Feet Below Land Surface	Other (specify):
Drawdown [(B) – (A)]: Feet Below Land Surface	For flowing well, measured shut in head:feet
Test Pumping Rate:Gallons Per Minute	Well yielded GPM with a drawdown of
Duration of Pump Test (minimum 4 hours):hours	<u> </u>

I HEREBY CERTIFY that the above statements are true to the best on $\frac{M: chal S Haverd O - 673}{Print Name of Pump Installer and License No. (if applicable)}$	f my knowledge. Signature of Pump Installer	D
	DEC 0 3 2007	

BY: OLWR