USGS guid, (Iand-held GPS) Survey-grade GPS City State Zip Code Telephone No. DS 558-6380 Well Data Purpose of Well (circle one) Home Industrial Public Supply Irrigation Fish Culture Other: Date well drilling started: 10/31/08 Date well drilling completed: 10/31/08 If flowing, method of flow regulation: Valve MA Other (describe) Static Water Level: 5 feet above or clowykeircle one) land surface Date measured: 10/31/08 Method of Measurement (circle one) steel tape electric tape air line other: Type of grout (circle one): Cernent Bentonite Mix Casing length: 10 feet Screen diameter: 1 inches Type of casing: PVC Screen slot size: 000 inches Setting depth: From 65 feet to 75 feet Type of completion (circle all applicable): Gravel packed Undereamed Telescoped Open hole Natural Development Other (describe): Top of lap pipe or reduction in casing: MA feet. If telescoped or more than one screen, describe on back of page Logs run (circle all applicable): No log run Electric Gamma Ray Density Sonic Neutron Other: Name of organization running log(s): MA Signature of Water Well Contractor and License No. Signature of Water Well Contractor and License No.	County: JOCKSOD Permit #: Driller: OOCH WATER WELLSRV. Date drilling completed: 10-31-08 (601)	Well	Location "Longitude <u>088 • 33 · 355</u> "
Purpose of Well (circle one) Industrial Public Supply Irrigation Fish Culture Other:	City State Zip Code	NE 1/2 NW1/2 Sec 26	Twn 755 Rng RGW
Name of organization running log(s): N/A I certify that the well was drilled, constructed, and completed in accordance with all applicable requirements of the Mississippi Department of Environmental Quality and/or the Mississippi Department of Health regulations and state laws. Jack Ridgdell 0-472 Print Name of Water Well Contractor and License No. Signature of Water Well Contractor	Date well drilling started: $10/31/08$ Date well drilling started of flow regulation: Valve N/A Other (de Static Water Level:	ell drilling completed: escribe) and surface Date measured: well grouted to a depth of inches Type of casing: feet to eamed Telescoped Open	$\frac{ 3 08}{ 0 3 08}$ $\frac{ 0 3 08}{ 0 }$ $\frac{ 0 3 08}{ 0 }$ $\frac{ 0 }{ 0 }$ feet $\frac{PVC}{ 0 }$ $\frac{PVC}{ 0 }$ feet hole Natural Development
the state of the s	Logs run (circle all applicable): No log run Electric Gamma Ray Name of organization running log(s): N/A I certify that the well was drilled, constructed, and completed in a Department of Environmental Quality and/or the Mississippi Dep Jack Ridgdell 0-472	ccordance with all applicable artment of Health regulations	requirements of the Mississippi and state laws.

BY:	\mathbf{O}	-	W	R
Barrie P. C.	9. A	ñ	A 10	1 5

بند الله المراجع (ال المراجع (الم


G-199

If well telescopes please sketch below and show depths.

Ground Level

Description of Formations Encountered	From To	571
TopSoil Orange clay White coarse sand	3 4	2
		_

If more than one screen, show location of each on sketch

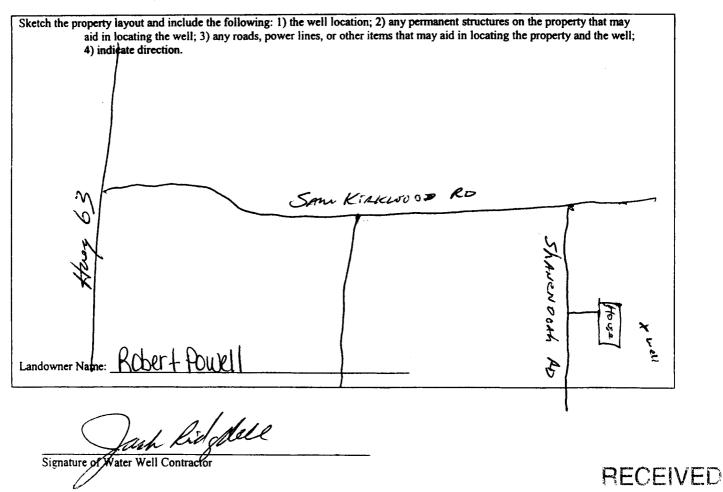

NOV 2 2 2008 BY: OLWR

STATE WELL REPORT				
County: <u>JACKSON</u> Permit #: Office of Land	Part 2 S Completion Report nt of Environmental Quality and Water Resources Box 10631			
(601	Box 10631 MS 39289-0631 I) 961-5210 B54-6938 (fax)			
This report should be prepared by the pump installer in deta	ail and filed with the Department within 30 days of the			
installation of pump. Well Owner Information	Well Location			
Owner Name: Robert POWell	Latitude: <u>2035'398''</u> Longitude: <u>088'33'35</u> 8''			
Mailing Address: 16912 Shanendoah Rd.	Method of Lat/Long (circle one): Conventional Survey,			
MOSS Point, MS 391562	USGS quad, (Hand-held GPS) Survey-grade GPS NF 1/2 NW/2 Sec 26 Twn T55 Rng R6 W			
City State Zip Code	Distance Direction Nearest Town			
Telephone No. 228 588 - 6380	31/2 Miles South of WADE			
Ритр Турс	Power Type			
Circle one	Circle one			
Air Lift Jet Submersible	Diesel Engine Gasoline Engine Natural Gas			
Bucket Piston Turbine	Electric Motor Hand Tractor PTO			
Centrifugal Rotary Flowing Well	Windmill Other (specify):			
Other (specify):	Horse Power Rating of Motor: 1 H.P.			
Date Pump Installed:	Setting Depth: <u>40FT. Droppipe</u> feet			
Rated Pump Capacity: & Gallons Per Minute	Number of Stages:			
Pump Test Data	Method of Measuring Water Level Circle one			
Date Well Tested: 11-1-08				
Static Water Level (A):Feet Below Land Surface				
Pumping Water Level (B): NA Feet Below Land Surface	Other (specify):			
Drawdown [(B) – (A)]: <u>NA</u> Feet Below Land Surface	For flowing well, measured shut in head: NA feet			
Test Pumping Rate: 8,5 Gallons Per Minute	Well yielded GPM with a drawdown of			
Duration of Pump Test (minimum 4 hours):	NA feet after NA hours of pumping			
J HEREBY CERTIFY that the above statements are true to the best of <u>Jack Ridgdell</u> 0-472. Print Name of Pump Installer and License No. (if applicable)	of my knowledge Jaw Japlice Signature of Pump Installer RECENCED			
	NUV 2 1 2008			
	BY: OLWR			

•

.

.