State W	ell Report	
	Part 1 For Office Use Only:	
Mississippi Departmen	tt of Environmental Quality Aquifer: <u>6213</u>	
	Office of Land and Water Resources P.O. Box 10631 Weil #:	
	IS 39289-0631 L. S. Elevation:	
	961-5210 64-6938 (fax) E-log #:	
State Law requires that this report be prepared by the 30 days of completion of drilling of the well.	driller in detail and filed with the Department within	
Well Owner Information	Well Location	
Owner Name Drian ROCKWEI	Latitude: 30 . 36 12,16" Longitude 088. 37. 44.46	
Mailing Address: Fish Lake Rd.	Method of Lat/Long (circle one): Conventional Survey,	
	USGS quad, Hand-held GPS, Survey-grade GPS	
MOSS HOINT, MS 39562 City State Zip Code	<u>501 1/2 560 1/2 Sec 18 Twn 755 Rng R6 W</u>	
Telephone No. (25) 443-2657	Distance Direction Nearest Town <u> <u> </u> <u> <u> </u> <u> </u></u></u>	
Weil	Data Housebert	
Date well drilling started: 5/27/11 Date w	Irrigation Fish Culture Other: CAMPS	
If flowing, method of flow regulation: Valve Other (d	escribe)	
Static Water Level:feet above of below circle one) I	and surface Date measured: <u>5/27/11</u>	
Method of Measurement (circle one) steel tape electric tape	air line other:	
Hole depth: 198 FT. Well depth: 198 FT.	Well grouted to a depth offeet	
Type of grout (circle one): Cement Bentonite Mix		
Casing length: 188 feet Casing diameter: 2	_inches Type of casing:	
Screen length: <u>0</u> feet Screen diameter: <u>2</u>	inches Type of screen:	
Screen slot size: <u>OCC</u> inches Setting depth: From _	88 feet to 98 feet	
Type of completion (circle all applicable): Gravel packed Under	reamed Telescoped Open hole Natural Development	
Other (describe):		
Top of lap pipe or reduction in casing: N/A feet. If tel	escoped or more than one screen, describe on back of page	
Logs run (circle all applicable): No log run Electric Gamma Ray	Density Sonic Neutron Other:	
Name of organization running log(s): N/A		
I certify that the well was drilled, constructed, and completed in a Department of Environmental Quality and/or the Mississippi Dep		
Tack Ridadell A-1177	artiment of freatin regulations and state laws.	
Print Name of Wester Well Control of Wester Wester		
Print Name of Water Well Contractor and License No.	Signature of Water Well Contractor	

le s


Lewis Printing - Pascagoula/NS



6213

If well telescopes please sketch below and show depths.

ĩ

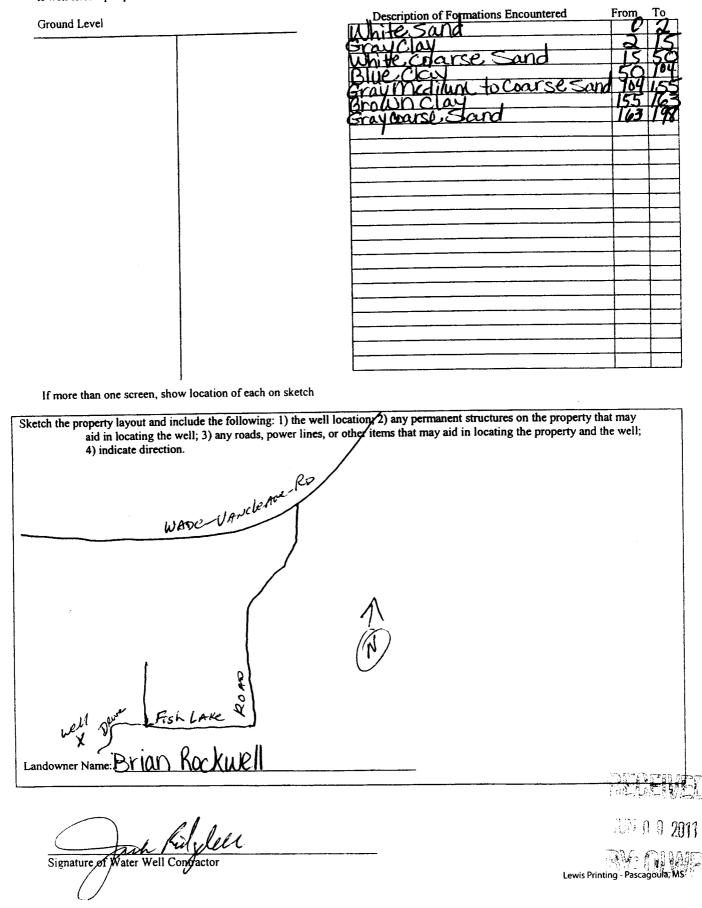

		STATE W	ELL REPORT		
County: Jackson Permit #: Driller Coast W Date completed: _5	ater wellsav	Pump Installer ⁴ Mississispi Departmen Office of Land P.O. Jackson, P (601	Part 2 s Completion Report nt of Environmental Quality and Water Resources Box 10631 MS 39289-0631 .) 961-5210 54-6938 (fax)	For Office Use Only: Aquifer:	
This report she	ould be prepared by t]	ail and filed with the Departm	ent within 30 days of the	
installation of	pump. Well Owner Informa	tion	We	ell Location	
Owner Name: Brian Ruckwell		Latitude: 3036 12,96" Longitude: 088 37'44.46"			
Mailing Address: Fish Lake Rd -			Method of Lat/Long (circle one): Conventional Survey, USGS quad, Hand-held GP9, Survey-grade GPS Sw 1/2 5w 1/4 Sec 18 Twn 735 Rng R6W		
Mossifiint, MS39562					
		Ċ			
Telephone No. 🔗	5)443-264	;7		of WADE	
	Pump Type		Pa	wer Type	
	Circle one			Circle one	
Air Lift	Jet	Submersible	Diesel Engine Gasoli	ne Engine Natural Gas	
Bucket	Piston	Turbine	Electric Motor Hand	Tractor PTO	
Centrifugal	Rotary	Flowing Well	1	(specify):	
Other (specify):			Horse Power Rating of Motor	r. 1 H.P.	
Date Pump Installed	5/30/11		Setting Depth. 40FT. Dr	oppipes feet	
Rated Pump Capacit	10	_Gallons Per Minute	Number of Stages:	2	
	Pump Test Data			easuring Water Level	
Date Well Tested:	5/30/11		Air Line Electric Mea	asuring Line Steel Tape	
Static Water Level (A):Feet	Below Land Surface	Other (specify):		
Pumping Water Lev	el (B): <u>N/A</u> Feet	Below Land Surface			
Drawdown [(B) – (A	1)]: <u>NA</u> Feet	Below Land Surface	For flowing well, measured sl	hut in head:feet	
Test Pumping Rate:	10	_Gallons Per Minute	Well yielded 30	GPM with a drawdown of	
Duration of Pump To	est (minimum 4 hours)	- <u>5</u> hours	feet after	NA hours of pumping	
	·····		I		
TACK RIAC	Y that the above states $0 - 4$	nents are true to the best o	f my knowledge.	Sdeer Harris	
Print Name of Pump	Installer and License 1	No. (if applicable)	Signature of Pump If		
				1000 A 250 A 4	

•