

State Well Report

Part 1

Mississippi Department of Environmental Quality
Office of Land and Water Resources
P.O. Box 10631
Jackson, MS 39289-0631
(601) 961-5210
(601) 354-6938 (fax)

For Office Use Only:

Aquifer: G 219
Well #: _____
L. S. Elevation: _____
E-log #: _____

County: Jackson
Permit #: _____
Driller: Cons Water Wells SRV.
Date drilling completed: 5/14/12

State Law requires that this report be prepared by the driller in detail and filed with the Department within 30 days of completion of drilling of the well.

Well Owner Information	Well Location
Owner Name: <u>Gerald Coleman</u>	Latitude: <u>30° 37' 23.34"</u> Longitude: <u>088° 33' 52.8"</u>
Mailing Address: <u>2854 Willkibby Rd.</u>	Method of Lat/Long (circle one): Conventional Survey, USGS quad, <u>Hand-held GPS</u> Survey-grade GPS
<u>Miss Point, MS 39562</u> City State Zip Code	<u>SE 1/4 SE 1/4 Sec 10</u> Twn <u>T6S</u> Rng <u>R5W</u>
Telephone No. <u>228 209-6012</u>	Distance <u>1/2</u> Miles Direction <u>SOUTH</u> of Nearest Town <u>WARR</u>

Well Data

Purpose of Well (circle one) Home Industrial Public Supply Irrigation Fish Culture Other: _____

Date well drilling started: 5/14/12 Date well drilling completed: 5/14/12

If flowing, method of flow regulation: Valve N/A Other (describe) _____

Static Water Level: 30 feet above or below (circle one) land surface Date measured: 5/14/12

Method of Measurement (circle one) steel tape electric tape air line other: _____

Hole depth: 60 FT Well depth: 60 FT Well grouted to a depth of 10 feet

Type of grout (circle one): Cement Bentonite Mix

Casing length: 50 feet Casing diameter: 4 inches Type of casing: PVC

Screen length: 10 feet Screen diameter: 4 inches Type of screen: PVC

Screen slot size: .010 inches Setting depth: From 50 feet to 60 feet

Type of completion (circle all applicable): Gravel packed Underreamed Telescoped Open hole Natural Development

Other (describe): _____

Top of lap pipe or reduction in casing: N/A feet. If telescoped or more than one screen, describe on back of page

Logs run (circle all applicable): No log run Electric Gamma Ray Density Sonic Neutron Other: _____

Name of organization running log(s): N/A

I certify that the well was drilled, constructed, and completed in accordance with all applicable requirements of the Mississippi Department of Environmental Quality and/or the Mississippi Department of Health regulations and state laws.

Jack Ridgell 0-472
Print Name of Water Well Contractor and License No.

Jack Ridgell
Signature of Water Well Contractor
JUN 06 2012
OLIVER

B219

If well telescopes please sketch below and show depths.


Ground Level

Blank area for sketching well telescopes and depths.

Description of Formations Encountered	From	To
Top Soil	0	2
Orange Clay	2	18
White coarse sand	18	60

If more than one screen, show location of each on sketch

Sketch the property layout and include the following: 1) the well location; 2) any permanent structures on the property that may aid in locating the well; 3) any roads, power lines, or other items that may aid in locating the property and the well; 4) indicate direction.

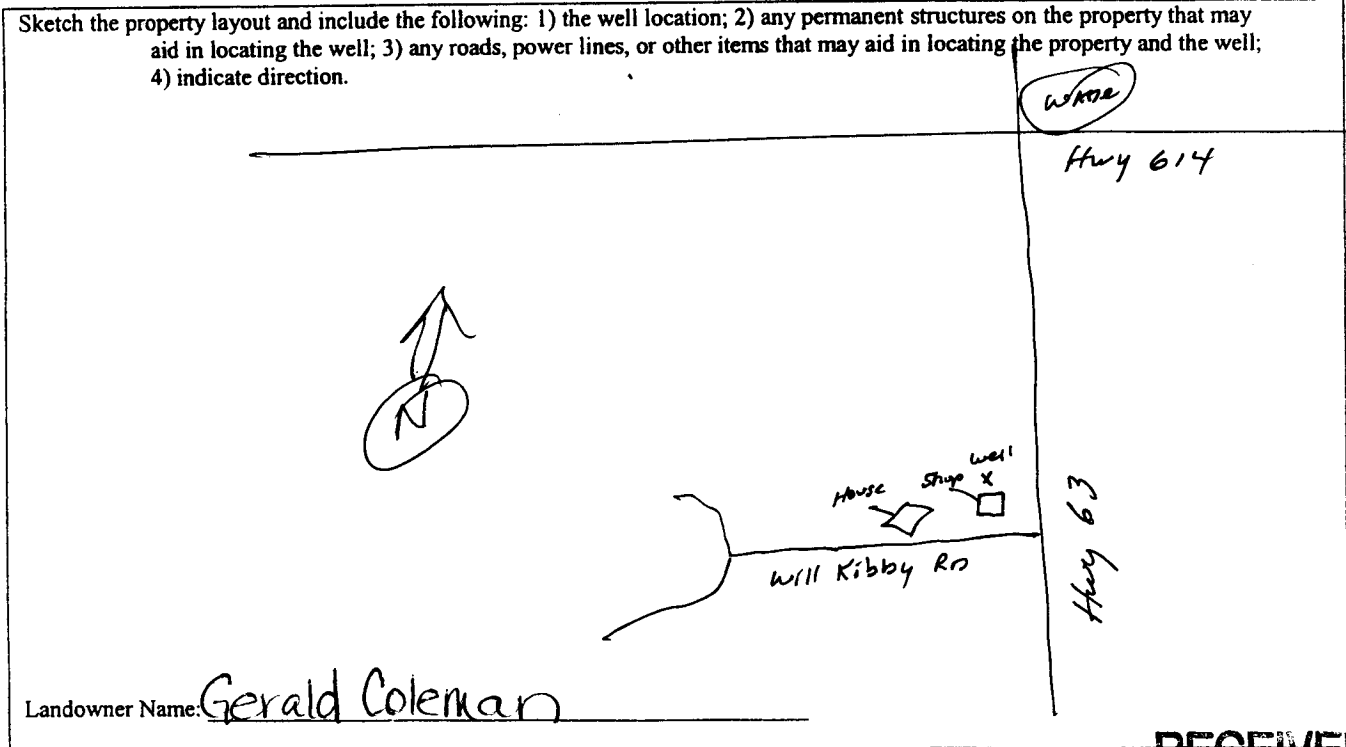

Landowner Name: Gerald Coleman

RECEIVED

Jack Rutledge
Signature of Water Well Contractor

JUN 08 2015
BY: OLWF
Lewis Printing - Pascagoula, MS

STATE WELL REPORT

Part 2

Pump Installer's Completion Report
 Mississippi Department of Environmental Quality
 Office of Land and Water Resources
 P.O. Box 10631
 Jackson, MS 39289-0631
 (601) 961-5210
 (601) 354-6938 (fax)

County: Jackson
 Permit #: _____
 Driller: East Water Wells Serv.
 Date completed: 5/14/12

For Office Use Only:

Aquifer: _____
 Well #: 6219
 Elevation: _____

This report should be prepared by the pump installer in detail and filed with the Department within 30 days of the installation of pump.

Well Owner Information	Well Location
Owner Name: <u>Gerald Coleman</u>	Latitude: <u>30° 37' 23.34"</u> Longitude: <u>088° 33' 52.86"</u>
Mailing Address: <u>2854 Will Kibby Rd.</u>	Method of Lat/Long (circle one): Conventional Survey, USGS quad, <u>Hand-held GPS</u> Survey-grade GPS
<u>Miss Point, MS 39562</u>	_____ ¼ _____ ¼ Sec _____ Twn _____ Rng _____
City State Zip Code	Distance Direction Nearest Town
Telephone No. <u>(601) 209-6012</u>	_____ Miles _____ of _____

Pump Type Circle one	Power Type Circle one
Air Lift Jet <u>Submersible</u>	Diesel Engine Gasoline Engine Natural Gas
Bucket Piston Turbine	<u>Electric Motor</u> Hand Tractor PTO
Centrifugal Rotary Flowing Well	Windmill Other (specify): _____
Other (specify): _____	Horse Power Rating of Motor: <u>1 HP</u>
Date Pump Installed: <u>5/15/12</u>	Setting Depth: <u>50 FT Drop Pipe</u> feet
Rated Pump Capacity: <u>19</u> Gallons Per Minute	Number of Stages: <u>9</u>

Pump Test Data	Method of Measuring Water Level Circle one
Date Well Tested: <u>5/15/12</u>	<u>Air Line</u> Electric Measuring Line Steel Tape
Static Water Level (A): <u>30</u> Feet Below Land Surface	Other (specify): _____
Pumping Water Level (B): <u>N/A</u> Feet Below Land Surface	For flowing well, measured shut in head: <u>N/A</u> feet
Drawdown [(B) - (A)]: <u>N/A</u> Feet Below Land Surface	Well yielded <u>30</u> GPM with a drawdown of
Test Pumping Rate: <u>22</u> Gallons Per Minute	<u>N/A</u> feet after <u>N/A</u> hours of pumping
Duration of Pump Test (minimum 4 hours): <u>4</u> hours	

RECEIVED

I HEREBY CERTIFY that the above statements are true to the best of my knowledge.

Jack Ridgell 0-472 Jack Ridgell
Signature of Pump Installer

Print Name of Pump Installer and License No. (if applicable) BY CLAW

JUN 06 2012