

STATE WELL REPORT

62

County: Jackson
Permit #:
Driller: Michael Fryfogle
Date drilling completed: 08/18/2021

Part 1
Driller's Log
Mississippi Department of Environmental Quality
Office of Land and Water Resources
P.O. Box 2309
Jackson, MS 39225-2309
(601)961-5555
(601)961-5228 (fax)

For Office Use Only:
Well #: G249
Aquifer:
E-Log #:

State Law requires that this report be prepared by the license holder responsible for the work and filed with the Department at the above address within 30 days of completion of drilling of the well or borehole.

Well Owner Information
(Landowner if borehole is not for a water well)
Owner Name: Latner Naramoore
Mailing Address: 17774 John Cumbest rd
Moss Point Ms 39562
City State Zip Code
Telephone No. ()
Well or Borehole Location
Latitude: 30.6034320 Longitude: -88.5677020
Method of Lat/Long (check one): Conventional Survey,
USGS quad, Hand-held GPS [X], Survey-grade GPS
NE 1/4 NE 1/4, Sec 22 T 5S R 6W
5.86 Miles SW of Hurley
(Distance) (Direction) (Nearest Town)


Well / Borehole Data
Date drilling started: 08/18/2021 Date drilling completed: 08/18/2021 Hole depth: 80 Hole diameter: 4 1/2
Location of the source of any surface water used for drilling: None
Method of dosing and volume of Chlorine used in drilling and development:
Logs run (check all applicable): No log run [X] Electric Gamma Ray Density Sonic Neutron Other:
Name of organization running log(s):
Purpose of borehole (check one): Water Well [X] Geotechnical/Geological Investigation Ground Source Heat Pump
Seismic Survey Other (describe)
If drilling is not related to water well construction, skip the remainder of this block
Purpose of Well (check all applicable): Home [X] Industrial Public Supply Irrigation Fish Culture
Other (describe):
If a flowing well, method of flow regulation: Valve Other (describe)
Static Water Level: 20 feet [above or [X] below] land surface Date measured: 08/18/2021
Method of measurement (check one): Steel tape Electric tape Air line [X] Other (describe):
Well depth: 80 Well grouted to a depth of: 10 feet Type of grout (check one): Neat Cement Bentonite [X] Mix
Casing length: 70 feet Casing diameter: 2 inches Type of casing: Sch40
Screen length: 10 feet Screen diameter: 2 inches Type of screen: Wrap
Screen slot size: .10 inches Setting depth: From 70 feet to 80 feet
Type of completion (check all applicable): Gravel packed [X] Underreamed Open hole Natural Development
Other (describe):
Top of lap pipe or reduction in casing: feet
If telescoped or more than one screen, describe on next page

RECEIVED
AUG 24 2021
BY OLWR

County: Jackson
Permit #: _____

For Office Use Only:
Well #: _____

*The sketch below only required for water wells
If well telescopes, show depths on sketch.*

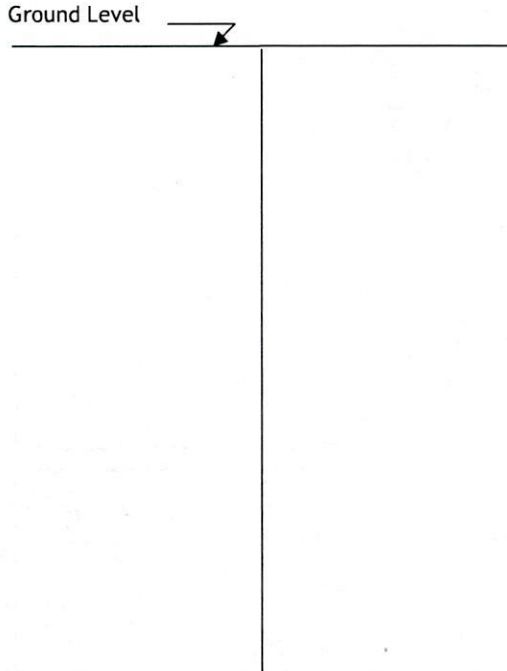


Description of formations encountered must be provided for all wells and boreholes, unless specifically exempted by regulations

Description of Formations Encountered	From (depth)	To (depth)
Clay	Ground level	18
Mix	18	32
Sand	32	80

If more than one screen, show location of each on sketch

- Sketch the property layout and include the following:
- 1) the well location
 - 2) any permanent structures on the property that may aid in locating the well
 - 3) any roads, power lines, or other items that may aid in locating the property and the well
 - 4) north arrow

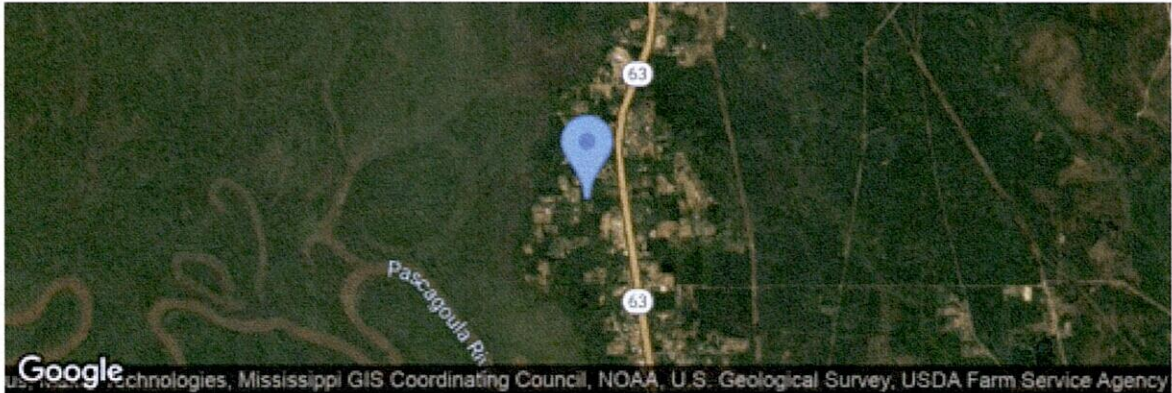

Landowner Name: Latner Naramoore

I HEREBY CERTIFY that the well/borehole was drilled, constructed, and completed in accordance with all applicable requirements of the Mississippi Department of Environmental Quality and the Mississippi Department of Health regulations, if applicable, and state laws.

Michael Fryfogle 0408 _____ 08/19/2021 _____
Print Name of Responsible Licensee and License No. Date



Michael Fryfogle _____
Signature of Licensee