

JACKSON

G 2000

WATER WELL DRILLERS LOG

Jackson


Date: 7-21-60, Driller: Jim P. ... County: ...

Owner of Land: Alex Shampine, Rt 2 - Pascagoula, Location: NW 1/4, SW 1/4, Sec 23 T. 6 R. 5, Range 6 West, 14 miles South of Moss Point, Topography: Level, Purpose of Well: Home

Table with 3 columns: Description & Color of Materials, Thickness Feet, Depth Feet. Contains handwritten entries for Clay and Sand.

Information upon completion of well:

(1) Diameter 9 inches, (2) Total Depth 42 feet, (3) Water Level 22 feet below top of ground, (4) Cased to 38, (5) Screen: Size 60, Length 4 feet

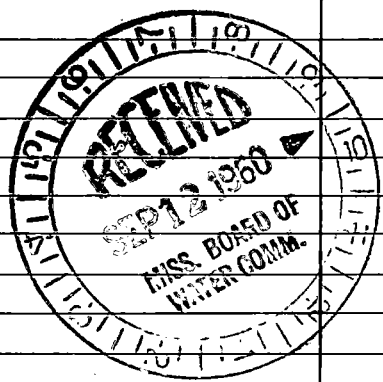

If YES depth of formation, Why, Drillers Remarks:

(Use Back Side)

Well No.

