

JACKSON MISSISSIPPI BOARD OF WATER COMMISSIONERS

G 700 *locates*

WATER WELL DRILLERS LOG

7-30-62

Date: July 30, 1962, Driller: Jim Colville County Jackson
 (Name)

(1) Owner of Land: Bunton Broome
 (Name)
Wade, Miss
 (Address)

(2) Location: SW 1/4, NE 1/4, Sec. 3 T48R14W
2 miles West, of Wade
 (distance) (direction) (Nearest Town)

(3) Topography: Hills
 (Hilly) (Flat) (Level)

(4) Purpose of Well: Domestic
 (Domestic Irrigation
 Municipal, Industrial, Other)

Description & Color of Materials Sand, Clay, Red Clay, Shell, etc.	Thick- ness Feet	Depth Feet
0-15 clay		
15-21 sand		
21-42 sand		
42-63 Gravel		
63-84 sand		
84-105 clay		
105-126 clay		
126-147 clay		
147-167 clay		
167-188 clay		
188-209 clay		
209-230 clay		
230-251 clay		
251-260 clay		
260-261 rock		
261-272 clay		
272-287 clay		
287-293 shale		
293-314 sand		
314-318 sand		

Information upon completion of well:

(1) Diameter 1 1/4 inches.

(2) Total Depth 318 feet.

(3) Water Level + 10' feet below top of ground.

(4) Cased to 308, Size _____


(5) Screen: Size 1 1/4, Length 10'

(6) Were any formations sealed against pollution?
 _____ yes, X no.

If YES depth of formation _____

Why _____

Drillers Remarks: _____

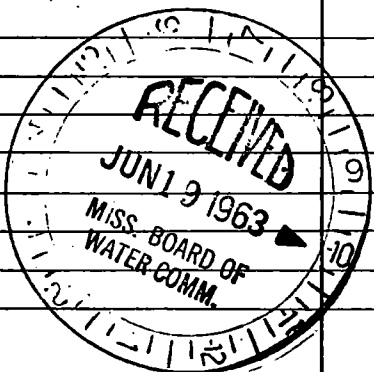

Well No. 167

(Use Back Side)

