


JACKSON
 G 2002
 9-20-75

MISSISSIPPI
 BOARD OF WATER COMMISSIONERS
 416 North State Street
 Jackson, Mississippi 39201

WATER WELL DRILLERS LOG

9-20-1975 M + H Well Co. JACKSON
 date well completed firm name county well located


LANDOWNER: <u>RICHARD GOFF</u>	description of formations encountered	from	to
<u>PASCAGOULA MISS.</u>	DIRT	1	2
(mailing address)	WHITE CLAY	2	8
WELL LOCATION:	BLUE CLAY	8	20
sec. <u>27-T-5-S</u> R. <u>6</u> E. <u>W</u>	FINE SAND	20	90
<u>0</u> miles of <u>THREE RIVERS</u>	SAND & GRAVEL	90	105
WELL PURPOSE: <u>Home</u> (home, irrigation, municipal, industrial)			
WELL COMPLETION DATA:			
(1) diameter (inches) <u>2</u> "			
(2) total depth (feet) <u>105'</u>			
(3) static water level (feet) <u>15'</u> ^{below} above top of ground.			
(4) casing <u>PLASTIC</u> , <u>101'</u> (material) (depth)			
_____ if telescope see back. (size)			
(5) screen <u>4'</u> , <u>101'</u> (length) (depth to top)			
<u>2"</u> , <u>PLASTIC</u> (size) (material)			
(6) pump <u>1</u> , <u>8</u> (HP) (yield gpm)			
<u>ELECTRIC</u> (type power)			
(7) electric log <u>NO</u> (yes or no)			
_____ (organization running log)			
(8) how well bottom plugged <u>BACK WASH VALVE</u>			
DRILLERS REMARKS:			

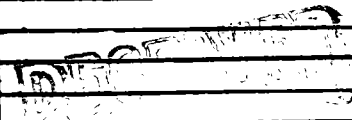

MAR 17 1976

If well telescopes please sketch and show depths.

GROUND LEVEL

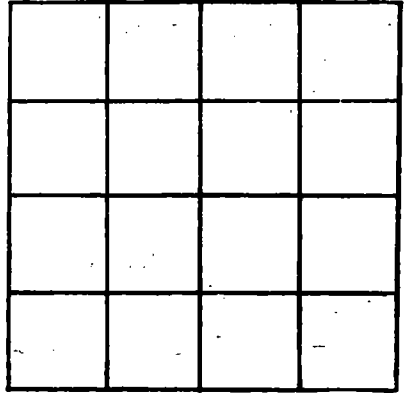

SECTION _____

Please indicate well location X.

ADDITIONAL INFORMATION

A series of horizontal lines for entering additional information.

If more than one screen, show locations of each on sketch.