

Jackson  
 5 2006  
 9-24-76

MISSISSIPPI  
 BOARD OF WATER COMMISSIONERS  
 416 North State Street  
 1972 Jackson, Mississippi 39201

WATER WELL DRILLERS LOG

9/24

1976 Driffin Wells Co

Jackson

date well completed

firm name

county well located

LANDOWNER: A Z Carter Jr

description of formations encountered

from

to

Rt 2

Pascagoula Miss  
 (mailing address)

send clay

0

2'

send

2'

60'

WELL LOCATION:

sec. 11 T 5 N R 6 E  
1 miles east of Wade  
 (distance) (direction) (nearest town)

yellow clay

60'

20'

WELL PURPOSE: Home  
 (home, irrigation, municipal, industrial)

Blue clay

20'

135'

WELL COMPLETION DATA:

(1) diameter (inches) 2"

med coarse sand

135'

200'

(2) total depth (feet) 350'

(3) static water level (feet) 4' <sup>below</sup> ~~above~~ top of ground.

Blue clay few

150'

(4) casing PVC, 335'  
 (material) (depth)

send streaks (thin)

325'

\_\_\_\_\_ if telescope see back.  
 (size)

(5) screen 15', 335'  
 (length) (depth to top)

fine sand

305'

157'

2", PVC  
 (size) (material)

(6) pump \_\_\_\_\_  
 (HP) (yield gpm)

\_\_\_\_\_ (type power)

(7) electric log no  
 (yes or no)

\_\_\_\_\_ (organization running log)

(8) how well bottom plugged Bad

RECEIVED


OCT 26 1976

DRILLERS REMARKS:

MISS. BD. OF WATER COMMISSIONERS

If well telescopes please sketch and show depths.

GROUND LEVEL

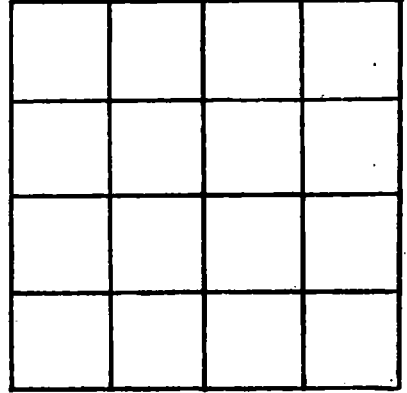

SECTION \_\_\_\_\_

Please indicate well location X.

ADDITIONAL INFORMATION

If more than one screen,  
show locations of each on sketch.