

JACKSON  
 G 2009  
 2-1-77

MISSISSIPPI  
 BOARD OF WATER COMMISSIONERS  
 416 North State Street  
 Jackson, Mississippi 39201

WATER WELL DRILLERS LOG

2-1-1977 date well completed  
 1302 27 COAST WATER WELL SERVICE firm name  
 Jackson county well located

LANDOWNER: Christalut Kelly  
PO Box 142  
Pascagoula Miss 39567  
 (mailing address)

description of formations encountered	from	to
top soil	0	3
grey clay	3	16
red sand	16	21
white clay	21	25
coarse sand + gravel	25	70

WELL LOCATION:  
 sec. 14 T S R 6  
 S W  
1 miles N of Three Rivers  
 (distance) (direction) (nearest town)

WELL PURPOSE:  
 (home, irrigation, municipal, industrial)

WELL COMPLETION DATA:  
 (1) diameter (inches) 2  
 (2) total depth (feet) 70  
 (3) static water level (feet) 25 <sup>below</sup> <sub>above</sub> top of ground.  
 (4) casing 2 (material) 45 (depth)  
2 If telescope see back. (size)  
 (5) screen 10 (length) 45 (depth to top)  
2 (size) PVC (material)  
 (6) pump      (HP)      (yield gpm)  
Elect (type power)  
 (7) electric log No (yes or no)  
     (organization running log)  
 (8) how well bottom plugged backwash  
Water


DRILLERS REMARKS:

RECEIVED  
 MAR 11 1977

MISS. BD. OF WATER COMM

If well telescopes please sketch and show depths.

GROUND LEVEL

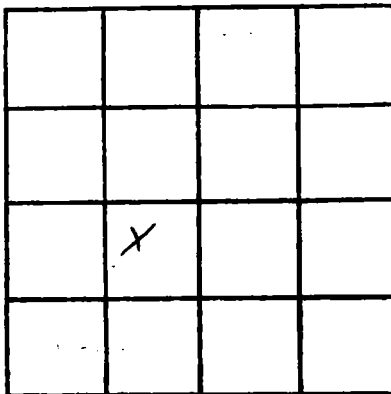

SECTION 14

Please indicate well location X.

ADDITIONAL INFORMATION

If more than one screen,  
show locations of each on sketch.