

JACKSON
G 2010
2/4/77

MISSISSIPPI
BOARD OF WATER COMMISSIONERS
416 North State Street
Jackson, Mississippi 39201

WATER WELL DRILLERS LOG

Feb 4 1977 ¹³² Celis Drilling Co Jackson
date well completed firm name county well located

LANDOWNER: Charles Persons Wade (mailing address)	description of formations encountered	from	to
WELL LOCATION: sect 11 T 5 N R 6 E W 3 Rivers 15 miles (distance) S N (direction) of P (nearest town)	fine clay	0	10
WELL PURPOSE: Home (home, irrigation, municipal, industrial)	sand	10	22
WELL COMPLETION DATA:	sand	22	44
(1) diameter (inches) 2"	sand	44	66
(2) total depth (feet) 300	sand	66	88
(3) static water level (feet) 8' below top of ground	sand	88	90
(4) casing plastic, 295 (material) (depth)	clay	90	110
2 in (size) if telescope see back.	clay	110	132
(5) screen 510-295 (length) (depth to top)	clay	132	154
2 in, plastic (size) (material)	clay	154	176
(6) pump 1 HP 12 (HP) (yield gpm)	clay	176	198
elec. (type power)	clay	198	220
(7) electric log no (yes or no)	clay	220	242
(organization running log)	clay	242	264
(8) how well bottom plugged BP valve	sand TD	264	286
		286	300


RECEIVED
MAR 14 1977

MISS. BD. OF WATER COMM

DRILLERS REMARKS:

If well telescopes please sketch and show depths.

GROUND LEVEL

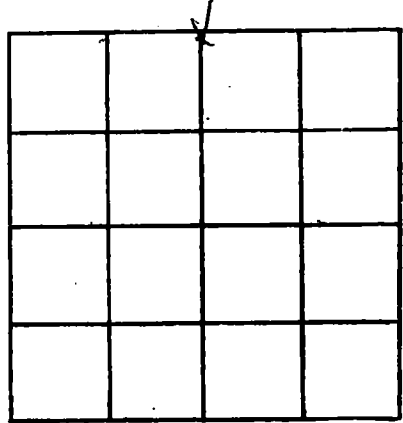

SECTION 11

Please indicate well location X.

ADDITIONAL INFORMATION

If more than one screen, show locations of each on sketch.