

Jackson
 2011
 8/26/77

MISSISSIPPI
 BOARD OF WATER COMMISSIONERS
 416 North State Street
 Jackson, Mississippi 39201

WATER WELL DRILLERS LOG

8-26-1977 date well completed
 Coast Water Well Serv. firm name
 Jackson county well located

LANDOWNER: Arthur Gunn
 36 Belvoir Ct.
 Moss Point, Miss 3956
 (mailing address)

description of formations encountered	from	to
Top soil	0	2
Grey Clay	2	21
Sand (mc) gravel	21	80
Blue Clay	80	385
Sand (m)	385	397
Blue Clay	397	860
Sand (m)	860	875

WELL LOCATION:
 sec. 25 T. 5 S. R. 6 E.
 10 miles NORTH of Escatawpa
 (distance) (direction) (nearest town)

WELL PURPOSE: Home
 (home, irrigation, municipal, industrial)

WELL COMPLETION DATA:
 (1) diameter (inches) 2"
 (2) total depth (feet) 875'
 (3) static water level (feet) below top of ground
 (4) casing P.V.C. 865'
 (material) (depth)
 2" (size) If telescope see back.
 (5) screen 10' 865'
 (length) (depth to top)
 2" (size) PVC (material)
 (6) pump 1/2 hp. 7
 (HP) (yield gpm)
 (type power)
 (7) electric log No
 (yes or no)
 (organization running log)

(8) how well bottom plugged
 Backwash Valve


DRILLERS REMARKS:

RECEIVED
 JAN - 9 1978

MISS. BD. OF WATER C.

If well telescopes please sketch and show depths.

GROUND LEVEL

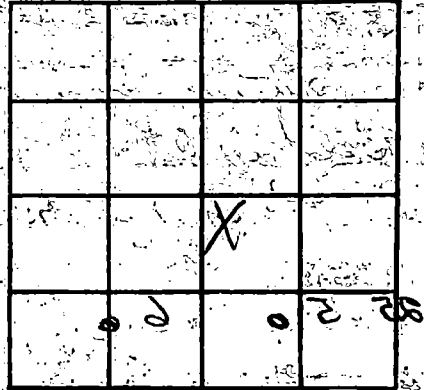

SECTION 25

Please indicate well location X:

ADDITIONAL INFORMATION

If more than one screen, show locations of each on sketch.