

Jackson
 5 2002
 10/14/77

MISSISSIPPI
 BOARD OF WATER COMMISSIONERS
 416 North State Street
 Jackson, Mississippi 39201

WATER WELL DRILLERS LOG

10-14 date well completed 19 77 Cross Water Well Serv. firm name Jackson county well located

LANDOWNER Famila C. Welchak
Rt 5, Box 231 B.
Pascagoula Miss 39567
 (mailing address)

WELL LOCATION:
 sec. 11 T 5 S R. 6 E
1 miles South of Wade
 (distance) (direction) (nearest town)

WELL PURPOSE: none
 (home, irrigation, municipal, industrial)

WELL COMPLETION DATA:
 (1) diameter (inches) 2"
 (2) total depth (feet) 306
 (3) static water level (feet) 10' ^{below}/_{above} top of ground.
 (4) casing P.U.C., 296'
 (material) (depth)
2"
 (size) If telescope see back.
 (5) screen 10', 296'
 (length) (depth to top)
2", P.U.C.
 (size) (material)
 (6) pump L.V.P., 10
 (HP) (yield gpm)
Electric
 (type power)
 (7) electric log No.
 (yes or no)
 (organization running log)

(8) how well bottom plugged
back wash water

DRILLERS REMARKS:


description of formations encountered	from	to
<u>Top Soil</u>	<u>0</u>	<u>3</u>
<u>Red Clay</u>	<u>3</u>	<u>17</u>
<u>Sand gravel</u>	<u>17</u>	<u>98</u>
<u>Blue Clay</u>	<u>98</u>	<u>226</u>
<u>Sand (MF)</u>	<u>226</u>	<u>240</u>
<u>Blue Clay</u>	<u>240</u>	<u>274</u>
<u>Sand (MF)</u>	<u>274</u>	<u>290</u>
<u>Blue Clay</u>	<u>290</u>	<u>292</u>
<u>Sand (M.)</u>	<u>292</u>	<u>306</u>

RECEIVED
 JAN 17 1978

MISS. BD. OF WATER COMMISSIONERS

If well telescopes please sketch and show depths.

GROUND LEVEL

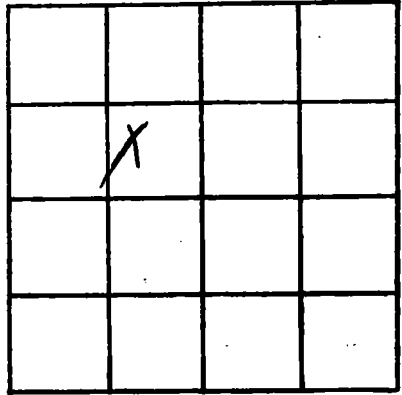

SECTION 11

Please indicate well location X.

ADDITIONAL INFORMATION

If more than one screen,
show locations of each on sketch.