

**JACKSON**  
 G-9080  
 9-23-79

MISSISSIPPI  
 BOARD OF WATER COMMISSIONERS  
 416 North State Street  
 Jackson, Mississippi 39201

WATER WELL DRILLERS LOG

9/23 1979 Pine Pulling Co. Jackson  
 date well completed firm name county well located

LANDOWNER: Ron Madson  
Rt. 6 Box 254 E  
Pocogula, Miss.  
 (mailing address)

WELL LOCATION:  
 sec. 31 T. 58 R. 68  
30 miles South of Medala  
 (distance) (direction) (nearest town)

WELL PURPOSE:  
 (home) irrigation, municipal, industrial

- WELL COMPLETION DATA:
- (1) diameter (inches) 2 1/2"
  - (2) total depth (feet) 240'
  - (3) static water level (feet) 20' below above top of ground
  - (4) casing Plastic 2 3/8" (material) (depth)
  - 0 (size) if telescope see back.
  - (5) screen 10' 240' (length) (depth to top)
  - 0/0 PLASTIC (size) (material)
  - (6) pump 1 9 (HP) (yield gpm)
  - Chc (type power)
  - (7) electric log (yes or no)
  - (organization running log)
  - (8) how well bottom plugged BW

description of formations encountered	from	to
<del>CLAY SAND</del> TOPSOIL	0	10
CLAY SAND	10	20
SAND	20	40
GOOD SAND	40	70
CLAY	70	220
GOOD SAND	220	240

DRILLERS REMARKS:


DEPT. OF NATURAL RESOURCES  
 BUREAU OF LAND & WATER RESOURCES

OCT 19 1979

RECEIVED

If well telescopes please sketch and show depths.

GROUND LEVEL

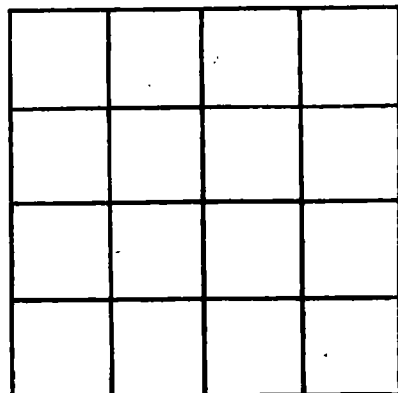

SECTION \_\_\_\_\_

Please indicate well location X.

ADDITIONAL INFORMATION

If more than one screen,  
show locations of each on sketch.