

Jackson
 G 2021
 12-5-79

MISSISSIPPI
 BOARD OF WATER COMMISSIONERS
 416 North State Street
 Jackson, Mississippi 39201

WATER WELL DRILLERS LOG

12/15 1979 Pierce Drilling Co. Jackson Co.
 date well completed firm name county well located

LANDOWNER: Prestone Johnson
RT. 5 391
Pascagoula Ms.
 (mailing address)

description of formations encountered	from	to
TOP SOIL	0	10
CLAY SAND	10	35
CLAY	35	40
GOOD SAND	40	65

WELL LOCATION:
 sec. 10 T-5 N R-6 E
2.2 miles south of Osborne
 (distance) (direction) (nearest town)

WELL PURPOSE:
 (home, irrigation, municipal, industrial)

- WELL COMPLETION DATA:
- (1) diameter (inches) 2"
 - (2) total depth (feet) 65'
 - (3) static water level (feet) 18 ^(below) above top of ground
 - (4) casing Plastic 60'
 (material) (depth)
 - 6 if telescope see back.
 (size)
 - (5) screen 5' 65'
 (length) (depth to top)
 - 010 Plastic
 (size) (material)
 - (6) pump 1 15
 (HP) (yield gpm)
 - Gas
 (type power)
 - (7) electric log yes (yes or no)
 - (organization running log)
 - (8) how well bottom plugged BW

DEPT. OF NATURAL RESOURCES
 BUREAU OF LAND & WATER RESOURCES


FEB 22 1980

RECEIVED

DRILLERS REMARKS:

If well telescopes please sketch and show depths.

GROUND LEVEL

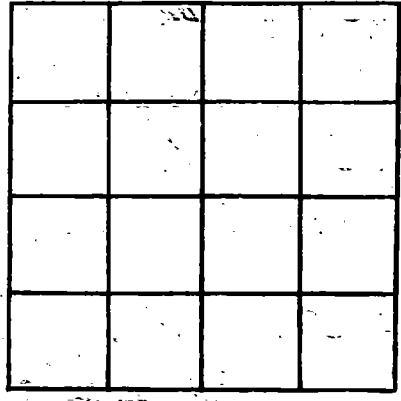

SECTION _____

Please indicate well location X.

ADDITIONAL INFORMATION

A series of 20 horizontal lines providing space for additional information or notes.

If more than one screen, show locations of each on sketch.