

**MISSISSIPPI
BOARD OF WATER COMMISSIONERS
416 North State Street
Jackson, Mississippi 39201**

WATER WELL DRILLERS LOG

JACKSON
G 2082
10-5-79

10-5-79 date well completed 1979 Coors Water Well Service firm name Jackson county well located

LANDOWNER: Jimmie Claus
P.O. Box 249
Pascagoula, Miss.
(mailing address) 39567

description of formations encountered	from	to
Red Clay	1	18
Red Coarse sand	18	60
White Coarse sand	60	69
White Coarse sand + wood	69	74
White Coarse sand + gravel	74	89
Blue Clay	89	280
Blue Clay + Oyster shell	280	335
Gray Coarse sand	335	365

WELL LOCATION:
sec. 10 T 5 S R 6 W
1 mile South of Wade.
(distance) (direction) (nearest town)

WELL PURPOSE: Home
(home, irrigation, municipal, industrial)

WELL COMPLETION DATA:

(1) diameter (inches) 3"

(2) total depth (feet) 365

(3) static water level (feet) 5 below above
top of ground.

(4) casing PVC 355'
(material) (depth)

2"
(size) If telescope see back.

(5) screen 10' 355'
(length) (depth to top)

2" PVC
(size) (material)

(6) pump 1/2 HP 12
(HP) (yield gpm)

Elect.
(type power)

(7) electric log No.
(yes or no)

(organization running log)

(8) how well bottom plugged:
vac. West Valve

DRILLERS REMARKS:


DEPT. OF NATURAL RESOURCES
BUREAU OF LAND & WATER RESOURCES

FEB 26 1980

RECEIVED

If well telescopes please sketch and show depths.

GROUND LEVEL

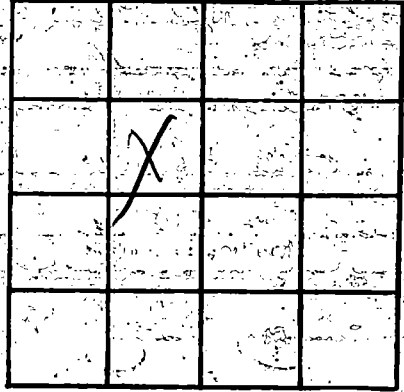

SECTION 10

Please indicate well location X.

ADDITIONAL INFORMATION

If more than one screen, show locations of each on sketch.