

JACKSON
G 2025
5-15-81

MISSISSIPPI
BOARD OF WATER COMMISSIONERS
416 North State Street
Jackson, Mississippi 39201

WATER WELL DRILLERS LOG

5, 15, 1981 date well completed
81 Cecil S. Howell Jackson county well located
21 Well firm name SW

LANDOWNER: Erin Steen Howell
Pascagoula Miss
(mailing address)

description of formations encountered	from	to
Dirt	0	2
Red dirt	2	6
Red clay	6	19
Sand	19	49


WELL LOCATION:
sec. 41 T. 5 N. R. 6 E.
1 miles S of Stennis
(distance) (direction) (nearest town)

WELL PURPOSE: Home
(home, irrigation, municipal, industrial)

- WELL COMPLETION DATA:
- (1) diameter (inches) 2"
 - (2) total depth (feet) 49
 - (3) static water level (feet) 26 below top of ground
 - (4) casing Plastic 49
(material) (depth)
 - (5) screen 5ft 44
(length) (depth to top)
2" Plastic
(size) (material)
 - (6) pump Electric 8
(type power) (yield/gpm)
 - (7) electric log _____
(yes or no)

(organization running log)

(8) how well bottom plugged Back Wash

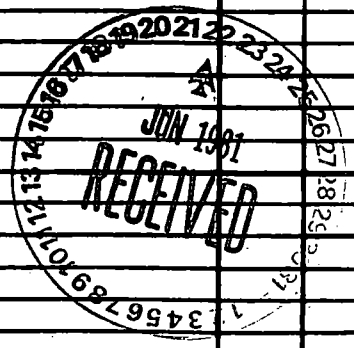

DRILLERS REMARKS:

If well telescopes please sketch and show depths.

GROUND LEVEL

SECTION _____

Please indicate well location X.

ADDITIONAL INFORMATION

If more than one screen, show locations of each on sketch.