

Jackson
G 2026
3-16-81

MISSISSIPPI
BOARD OF WATER COMMISSIONERS
416 North State Street
Jackson, Mississippi 39201

WATER WELL DRILLERS LOG

3-16-1981 date well completed
Hufford Well Service firm name
Jackson county well located

LANDOWNER: Bert Fisher

Lucedale, MS
(mailing address)

WELL LOCATION:

sec. 1 T 5 N R 6 E
5 miles S of Wade
(distance) (direction) (nearest town)

WELL PURPOSE:

(home) irrigation, municipal, industrial

WELL COMPLETION DATA: 3-16-81

- (1) diameter (inches) 2x4
- (2) total depth (feet) 330'
- (3) static water level (feet) 27' below top of ground
- (4) casing PVC 315' (material) (depth)
2x4 (size) if telescope see back.
- (5) screen 15' 315' (length) (depth to top)
2" PVC (size) (material)
- (6) pump 1/3 20 (HP) (yield gpm)
E/E (type power)
- (7) electric log (yes or no)

(organization running log)

(8) how well bottom plugged 2" PVC
Backwash

DRILLERS REMARKS:

description of formations encountered

from to


Top Soil	0	10
Sand	10	40
Yellow Clay	40	52
Sand	52	110
Blue Clay	110	145
Blue med. Sand	145	175
Blue Clay	175	250
med Blue Sand	250	285
Blue Clay	285	314
med Blue Sand	314	330
Clay ATTEL	330	

DEPT. OF NATURAL RESOURCES
BUREAU OF LAND & WATER RESOURCES

JUL 21 1981

RECEIVED

If well telescopes please sketch and show depths.

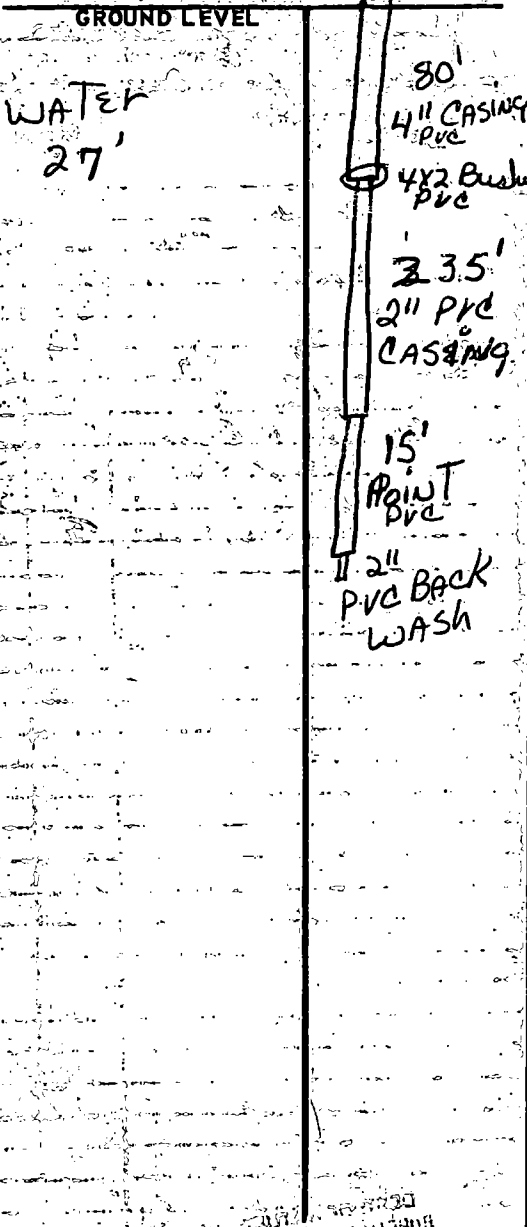

X			

SECTION 23

Please indicate well location X.

ADDITIONAL INFORMATION

If more than one screen, show locations of each on sketch.