

Jackson
 G ~~2018~~
 2028

MISSISSIPPI DEPARTMENT OF NATURAL RESOURCES
 Bureau of Land and Water Resources
 Southport Mall
 P.O. Box 10631
 Jackson, Mississippi 39209
WATER WELL DRILLERS LOG

3-28 1984 date well completed Pierce Drilling Co. firm name Jackson county well located

LANDOWNER: Curtis Bright

description of formations encountered

from to

Wade, Ms
 (mailing address)

<u>Topsoil</u>	<u>0</u>	<u>10</u>
<u>Clay</u>	<u>10</u>	<u>25</u>
<u>Good Sand</u>	<u>25</u>	<u>65</u>

WELL LOCATION:

sec. 3 T 5 N R 6 E
 (distance) (direction) (nearest town)
1 miles South of Wade

WELL PURPOSE:

(home, irrigation, municipal, industrial)

WELL COMPLETION DATA:

- (1) diameter (inches) 2"
- (2) total depth (feet) 65'
- (3) static water level (feet) 30 ^{below} above top of ground.
- (4) casing plastic, 60'
 (material) (depth)
0 if telescope see back.
 (size)
- (5) screen 5', 65'
 (length) (depth to top)
006, plastic
 (size) (material)
- (6) pump 1 12
 (HP) (yield gpm)
electric
 (type power)
- (7) electric log (yes or no)

(organization running log)

(8) how well bottom plugged BW

DRILLERS REMARKS:


DEPT. OF NATURAL RESOURCES
 BUREAU OF LAND AND WATER RESOURCES

JUN - 6 1984

RECEIVED

If well telescopes please sketch and show depths.

GROUND LEVEL

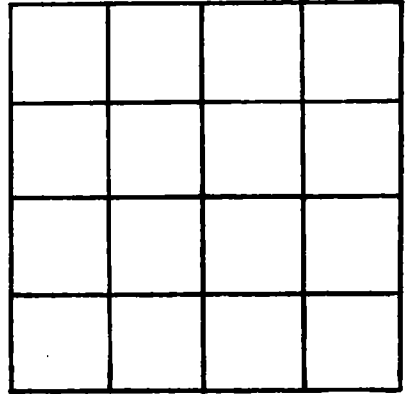

SECTION _____

Please indicate well location X.

ADDITIONAL INFORMATION

If more than one screen, show locations of each on sketch.