

MISSISSIPPI DEPARTMENT OF NATURAL RESOURCES

Bureau of Land and Water Resources

Southport Mall

P.O. Box 10631

Jackson, Mississippi 39209

WATER WELL DRILLERS LOG

Jackson
G 2032

2-11 1982 Price Drilling Co Jackson
date well completed firm name county well located

LANDOWNER: J.E. Powell
Rt 5 Box 165
Pascagoula, Ms
(mailing address)

description of formations encountered	from	to
<u>Top Soil</u>	<u>0</u>	<u>10</u>
<u>Sand</u>	<u>10</u>	<u>15</u>
<u>Clay</u>	<u>15</u>	<u>25</u>
<u>Good Sand</u>	<u>25</u>	<u>60</u>

WELL LOCATION:
sec. 26 5 N R. 6 E
20 miles South of Pascagoula
(distance) (direction) (nearest town)

WELL PURPOSE:
Home (irrigation, municipal, industrial)


- WELL COMPLETION DATA:
- (1) diameter (inches) 2"
 - (2) total depth (feet) 60'
 - (3) static water level (feet) 30' below above top of ground.
 - (4) casing plastic, 45'
(material) (depth)
none (size) if telescope see back.
 - (5) screen 5, 60'
(length) (depth to top)
008, plastic
(size) (material)
 - (6) pump 1 (HP) 8 (yield gpm)
Electric (type power)
 - (7) electric log (yes or no) _____
(organization running log) _____
 - (8) how well bottom plugged BW

DRILLERS REMARKS: _____

DEPT. OF NATURAL RESOURCES
BUREAU OF LAND & WATER RESOURCES
MAR 11 1982
RECEIVED

If well telescopes please sketch and show depths.

GROUND LEVEL

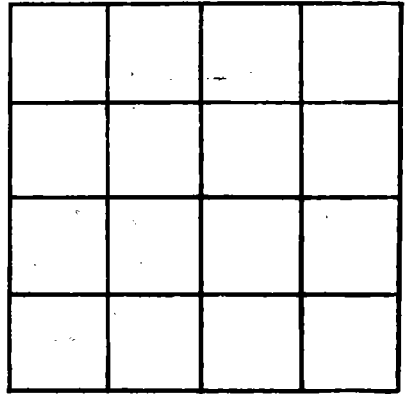

SECTION _____

Please indicate well location X.

ADDITIONAL INFORMATION

If more than one screen,
show locations of each on sketch.