

Jackson  
G2034

MISSISSIPPI  
BOARD OF WATER COMMISSIONERS  
416 North State Street  
Jackson, Mississippi 39201

WATER WELL DRILLERS LOG

3/13, 1982 Cecil S. Howells Jackson  
Date well completed Well firm name Service county well located

LANDOWNER: Anne Combes  
Pascagoula Miss  
(mailing address)

description of formations encountered	from	to
Top Soil	0	2
Red Clay	2	20
White Sand	20	40
Course Sand	40	57

WELL LOCATION:  
sec. 3 T 5 N R 6 E  
0 miles W of Pascagoula  
(distance) (direction) (nearest town)

WELL PURPOSE: Home  
(home, irrigation, municipal, industrial)

WELL COMPLETION DATA:

(1) diameter (inches) 2"

(2) total depth (feet) 57

(3) static water level (feet) 25 <sup>below</sup> above top of ground

(4) casing Plastic, 57  
(material) (depth)  
If telescope see back.  
(size)

(5) screen 5ft 52  
(length) (depth to top)  
2" Plastic  
(size) (material)

(6) pump 1 6  
(HP) (yield (gpm))  
Electric  
(type power)

(7) electric log \_\_\_\_\_  
(yes or no)  
(organization running log)

(8) how well bottom plugged Back Wash Valve

DRILLERS REMARKS:


DEPT. OF NATURAL RESOURCES  
BUREAU OF LAND & WATER RESOURCES

JUL 27 1982

RECEIVED

If well telescopes please sketch and show depths.

GROUND LEVEL

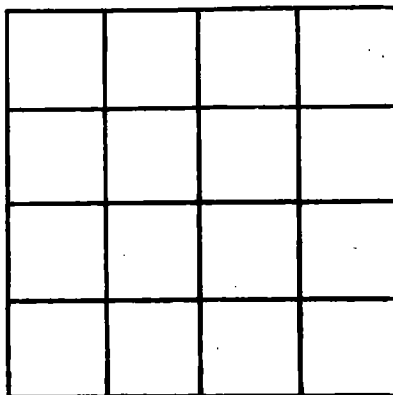

SECTION \_\_\_\_\_

Please indicate well location X.

ADDITIONAL INFORMATION

If more than one screen, show locations of each on sketch.