

MISSISSIPPI DEPARTMENT OF NATURAL RESOURCES
Bureau of Land and Water Resources
 Southport Mall
 P.O. Box 10631
 Jackson, Mississippi 39209
WATER WELL DRILLERS LOG

Jackson
G-2035

8-25 1982 Pierce Drilling Co Jackson
 date well completed firm name county well located

LANDOWNER: Tim Duncan
Wade
Pascagoula ms
 (mailing address)
 WELL LOCATION:
 sec. 2 T 5 N R 6 E
5 miles West of Husley
 (distance) (direction) (nearest town)

description of formations encountered	from	to
<u>Top Soil</u>	<u>0</u>	<u>15</u>
<u>Sand</u>	<u>15</u>	<u>25</u>
<u>Clay</u>	<u>25</u>	<u>40</u>
<u>Good Sand</u>	<u>40</u>	<u>70</u>

WELL PURPOSE:
 (~~Home~~, Irrigation, municipal, industrial)

WELL COMPLETION DATA:
 (1) diameter (inches) 2"
 (2) total depth (feet) 70'
 (3) static water level (feet) 30' below top of ground.
 (4) casing Plastic, 60'
 (material) (depth)
0 if telescope see back.
 (size)
 (5) screen 10', 20'
 (length) (depth to top)
008, Plastic
 (size) (material)
 (6) pump 1 12
 (HP) (yield gpm)
Electric
 (type power)
 (7) electric log (yes or no)
 (organization running log)
 (8) how well bottom plugged 3/4

DRILLERS REMARKS:


DEPT. OF NATURAL RESOURCES
 BUREAU OF LAND & WATER RESOURCES

SEP 21 1982

RECEIVED

If well telescopes please sketch and show depths.

GROUND LEVEL

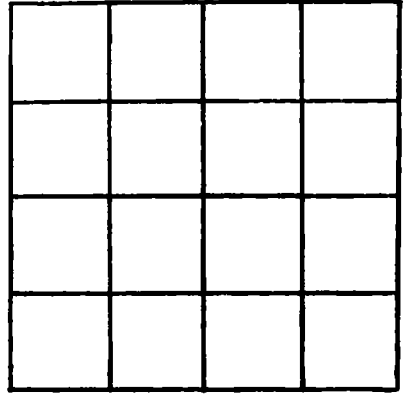

SECTION _____

Please indicate well location X.

ADDITIONAL INFORMATION

If more than one screen, show locations of each on sketch.