

Jackson
G 2037

MISSISSIPPI DEPARTMENT OF NATURAL RESOURCES
Bureau of Land and Water Resources
Southport Mall
P.O. Box 10631
Jackson, Mississippi 39209
WATER WELL DRILLERS LOG

11-29-82 19 Fry Fogle Water Well JACKSON
date well completed firm name county well located

LANDOWNER: JW Kirkwood
3024 Sam Kirkwood Dr
Pascagoula, ms 39567
(mailing address)

WELL LOCATION:
sec. 23 T-5 N R-6 E
(distance) miles (direction) of Three Rivers (nearest town)

WELL PURPOSE: Home
(home, irrigation, municipal, industrial)

- WELL COMPLETION DATA:
- (1) diameter (inches) 4"
 - (2) total depth (feet) 175
 - (3) static water level (feet) 46 below top of ground.
 - (4) casing PVC, 165 (material) (depth)
 - (size) If telescope see back.
 - (5) screen 10' (length), 165' (depth to top)
 - 4" (size), PVC (material)
 - (6) pump 1/3 (HP), 12 (yield gpm)
 - Electric (type power)
 - (7) electric log no (yes or no)
 - no (organization running log)
 - (8) how well bottom plugged PVC Baer chd

description of formations encountered	from	to
TOP SOIL	0	10
clay	10	20
sandy clay	20	40
SAND	40	50
clay	50	52
COARSE SAND	52	90
Brown Clay	90	120
Blue Clay	120	140
Fine Sand	140	150
COARSE BLUE SAND	150	175

DEPT. OF NATURAL RESOURCES
BUREAU OF LAND & WATER RESOURCES


FEB - 7 1983

RECEIVED

DRILLERS REMARKS:

If well telescopes please sketch and show depths.

GROUND LEVEL

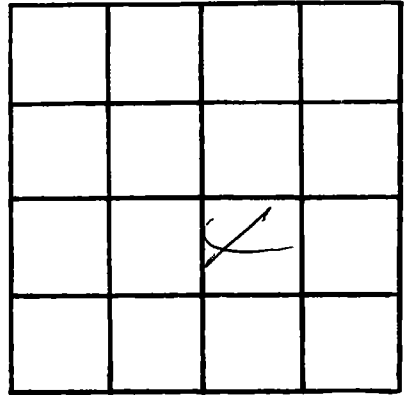

SECTION 26

Please indicate well location X.

ADDITIONAL INFORMATION

If more than one screen,
show locations of each on sketch.