

MISSISSIPPI DEPARTMENT OF NATURAL RESOURCES

Bureau of Land and Water Resources

Southport Mall

P.O. Box 10631

Jackson, Mississippi 39209

WATER WELL DRILLERS LOG

Jackson
G 2038

1-10-83 date well completed
Coast Water Well Serv. firm name
Jackson county well located

LANDOWNER: Joe Cumbs
17420 Highway 63
Pascagoula Miss.
(mailing address) 3567

WELL LOCATION:
sec 22 T 5 N R 6 E
3 miles SOUTH of WADE
(distance) (direction) (nearest town)

WELL PURPOSE: Home
(home, irrigation, municipal, industrial)

- WELL COMPLETION DATA:
- (1) diameter (inches) 2"
 - (2) total depth (feet) 274
 - (3) static water level (feet) 56' below top of ground
 - (4) casing PVC 264' (material) (depth)
2" (size) if telescope see back.
 - (5) screen 10' 264' (length) (depth to top)
2" PVC (size) (material)
 - (6) pump 1 HP 7 1/2 (HP) (yield gpm)
Elex (type power)
 - (7) electric log No. (yes or no)

description of formations encountered	from	to
Top soil	0	2'
Red Clay	2'	10'
Red Coarse sand	10'	64'
Red Coarse sand & gravel	64'	90'
Blue Clay	90'	104'
White Coarse sand	104'	129'
Blue Clay	129'	172'
Blue Clay & streak of sand	172'	193'
Blue Clay	193'	205'
Blue Clay & streak of sand	205'	214'
Blue Clay	214'	236'
Blue Clay & streak of sand	236'	246'
Gray Coarse sand	246'	274'

(8) How well bottom plugged
Pack Wash Valve

DRILLERS REMARKS:


DEPT. OF NATURAL RESOURCES
BUREAU OF LAND & WATER RESOURCES

FEB 18 1983

RECEIVED

If well telescopes please sketch and show depths.

GROUND LEVEL

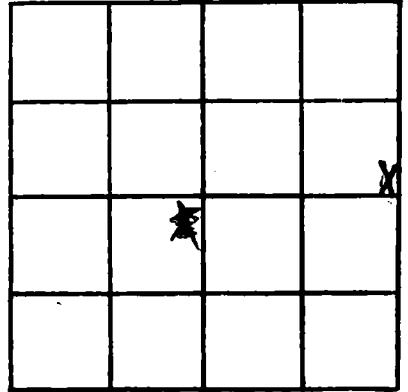

SECTION 22

Please indicate well location X.

ADDITIONAL INFORMATION

If more than one screen, show locations of each on sketch.