

MISSISSIPPI DEPARTMENT OF NATURAL RESOURCES

Bureau of Land and Water Resources

Southport Mall

P.O. Box 10631

Jackson, Mississippi 39209

WATER WELL DRILLERS LOG

JACKSON  
G 20.39  
5-13-83

5/13/83 19 Grader Pump Well Sen. Jackson  
date well completed, file name county well located

LANDOWNER: H. W. Parks  
2608 Pascagoula River Rd.  
Pascagoula, Ms. 39567  
(mailing address)

description of formations encountered	from	to
<u>Top soil - sand</u>	<u>0</u>	<u>20</u>
<u>white clay</u>	<u>20</u>	<u>30</u>
<u>sand</u>	<u>30</u>	<u>40</u>
<u>sand &amp; clay</u>	<u>40</u>	<u>50</u>
<u>sand</u>	<u>50</u>	<u>80</u>

WELL LOCATION:  
sec. 27 T. 5 S R. 6 E  
8 miles North of Escatawpa  
(distance) (direction) (nearest town)

WELL PURPOSE: Home  
(home, irrigation, municipal/Industrial)

WELL COMPLETION DATA:  
(1) diameter (inches) 2"  
(2) total depth (feet) 80  
(3) static water level (feet) 17 below top of ground.  
(4) casing PVC 70  
(material) (depth)  
2" If telescope see back.  
(size)  
(5) screen 5 70'  
(length) (depth to top)  
2 PVC  
(size) (material)  
(6) pump windmill 4  
(HP) (yield gpm)  
wind  
(type power)  
(7) electric log no  
(yes or no)  
(organization running log)  
(8) how well bottom plugged sandstone  
PVC

DEPT. OF NATURAL RESOURCES  
BUREAU OF LAND & WATER RESOURCES


MAY 20 1983

RECEIVED

DRILLERS REMARKS: 5 ft  
tailpipe

If well telescopes please sketch and show depths.

GROUND LEVEL

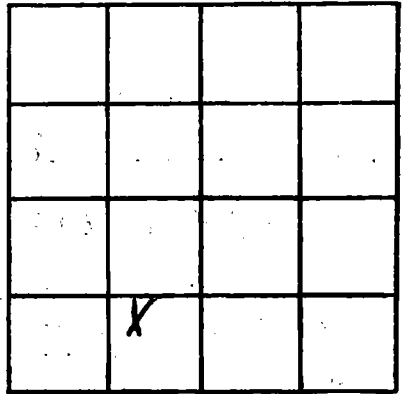

SECTION 27

Please indicate well location X.

ADDITIONAL INFORMATION

If more than one screen, show locations of each on sketch.