

MISSISSIPPI DEPARTMENT OF NATURAL RESOURCES
Bureau of Land and Water Resources
 Southport Mall
 P.O. Box 10631
 Jackson, Mississippi 39209
WATER WELL DRILLERS LOG

Jackson
G 2041

10-18 1983 Pierce Drilling Co. Jackson
 date well completed firm name county well located

LANDOWNER: Juddi. Valentin
Wade, Ms
 (mailing address)

description of formations encountered	from	to
<u>Top Soil</u>	<u>0</u>	<u>10</u>
<u>Clay</u>	<u>10</u>	<u>20</u>
<u>Red Sand</u>	<u>20</u>	<u>45</u>

WELL LOCATION:
 sec. 27 T. 5 N. R. 6 E.
1 miles West of 3-Rivers
 (distance) (direction) (nearest town)

WELL PURPOSE:
 (~~Home~~) Irrigation, municipal, industrial)

WELL COMPLETION DATA:

(1) diameter (inches) 2"

(2) total depth (feet) 45'

(3) static water level (feet) 10' ^{below} ~~above~~ top of ground.

(4) casing plastic, 40'
 (material) (depth)
0 if telescope see back.
 (size)

(5) screen 5, 45'
 (length) (depth to top)
006, plastic
 (size) (material)

(6) pump 1/2, 8
 (HP) (yield gpm)
Electric
 (type power)

(7) electric log (yes or no)
 (organization running log)

(8) how well bottom plugged BW

DEPT. OF NATURAL RESOURCES
 BUREAU OF LAND & WATER RESOURCES


FEB - 1 1984

RECEIVED

DRILLERS REMARKS:

If well telescopes please sketch and show depths.

GROUND LEVEL

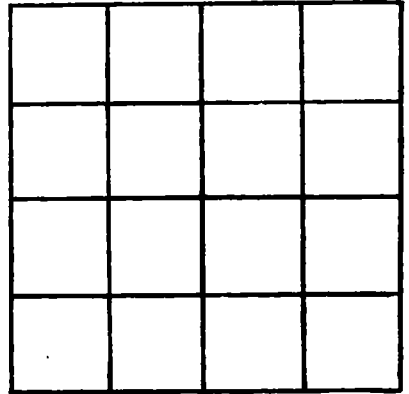

SECTION _____

Please indicate well location X.

ADDITIONAL INFORMATION

If more than one screen, show locations of each on sketch.