

MISSISSIPPI DEPARTMENT OF NATURAL RESOURCES
Bureau of Land and Water Resources
 Southport Mall
 P.O. Box 10631
 Jackson, Mississippi 39209
WATER WELL DRILLERS LOG

Jackson
G 7042

date well completed 12-10-83 firm name Pierce Drilling Co. county well located Jackson

LANDOWNER: Wanda Johnson

description of formations encountered

from to

<u>Top soil</u>	<u>0</u>	<u>10</u>
<u>Sand</u>	<u>10</u>	<u>25</u>
<u>Clay</u>	<u>25</u>	<u>55</u>
<u>Good Sand</u>	<u>55</u>	<u>75</u>

Wade Ms
 (mailing address)

WELL LOCATION:

sec. 11 T. 5 N. R. 6 E.
3 miles North of 3-Rivers
 (distance) (direction) (nearest town)

WELL PURPOSE:

(home, irrigation, municipal, industrial)

WELL COMPLETION DATA:

- diameter (inches) 2"
- total depth (feet) 75'
- static water level (feet) 20' ^{below} above top of ground.
- casing plastic, 70'
 (material) (depth)
0 if telescope see back.
 (size)
- screen 5, 75'
 (length) (depth to top)
006, plastic
 (size) (material)
- pump 1 0
 (HP) (yield gpm)
electric
 (type power)
- electric log (yes or no)

(organization running log)

- (8) how well bottom plugged SW

DEPT. OF NATURAL RESOURCES
 BUREAU OF LAND & WATER RESOURCES


FEB - 1 1984

DRILLERS REMARKS:

RECEIVED

If well telescopes please sketch and show depths.

GROUND LEVEL

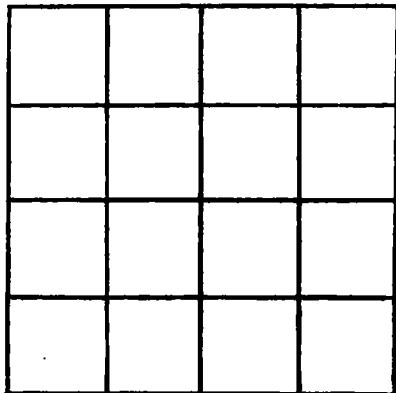

SECTION _____

Please indicate well location X.

ADDITIONAL INFORMATION

If more than one screen, show locations of each on sketch.