

MISSISSIPPI DEPARTMENT OF NATURAL RESOURCES

Bureau of Land and Water Resources

Southport Mall

P.O. Box 10631

Jackson, Mississippi 39209

WATER WELL DRILLERS LOG

Jackson
 G 2043

1-13 1984 Fryfogle Well Serv. Jackson
 date well completed firm name county well located

LANDOWNER: *Leroy Street*
Leroy
 Rt. 3, Box 257
 Lucedale, Ms 39452
 (mailing address)

description of formations encountered	from	to
<i>Topsoil & sand</i>	<i>0</i>	<i>10</i>
<i>clay</i>	<i>10</i>	<i>15</i>
<i>sand</i>	<i>15</i>	<i>30</i>
<i>clay</i>	<i>30</i>	<i>35</i>
<i>sand</i>	<i>35</i>	<i>68'</i>

WELL LOCATION:
 sec. *26* T. *5* N. R. *6* E
1/8 miles *North* of *Noss Point*
 (distance) (direction) (nearest town)

WELL PURPOSE:
 (home, irrigation, municipal, industrial)

WELL COMPLETION DATA:

(1) diameter (inches) *2"*

(2) total depth (feet) *68'*

(3) static water level (feet) *20* below above top of ground.

(4) casing *PVC* *63*
 (material) (depth)
2" if telescope see back.
 (size)

(5) screen *5'* *63*
 (length) (depth to top)
#8 *PVC*
 (size) (material)

(6) pump *1* *15*
 (HP) (yield gpm)
Ebe
 (type power)

(7) electric log *(yes or no)*
 (organization running log)

(8) how well bottom plugged *PVC*
Block

DEPT. OF NATURAL RESOURCES
 BUREAU OF LAND & WATER RESOURCES


JAN 20 1984

RECEIVED

DRILLERS REMARKS:

If well telescopes please sketch and show depths.

GROUND LEVEL

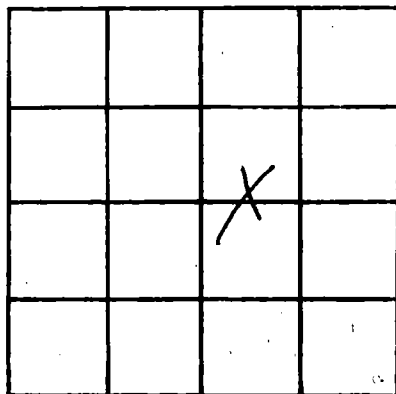

SECTION 1

Please indicate well location X.

ADDITIONAL INFORMATION

If more than one screen,
show locations of each on sketch.