

MISSISSIPPI DEPARTMENT OF NATURAL RESOURCES

Bureau of Land and Water Resources

Southport Mall

P.O. Box 10631

Jackson, Mississippi 39209

WATER WELL DRILLERS LOG

Jackson
G 2044

2-18-1984 Coast Water Well Sew. Jackson
date well completed firm name county well located

Mr. J. T. Thompson
LANDOWNER:

5136 Wrens St.
Miss Point Miss.
(mailing address) 39563

description of formations encountered from to

Top soil	0	2'
Red Clay	2'	40'
Blue Clay	40'	65'
Red coarse sand & gravel	65'	76'
Blue Clay	76'	89'
Red coarse sand & gravel	89'	112'
Blue Clay	112'	150'
Gray coarse sand	150'	190'
Blue Clay	190'	200'
(10' Tail pipe)		

WELL LOCATION:

sec. 36-5 _S R. 6 _W of Escatawpa
(distance) miles (direction) (nearest town)

WELL PURPOSE: Home
(home, irrigation, municipal, industrial)

WELL COMPLETION DATA:

(1) diameter (inches) 2"
(2) total depth (feet) 200'
(3) static water level (feet) 18' below top of ground.

(4) casing PVC, 190'
(material) (depth)
2" If telescope see back.
(size)

(5) screen 10', 190'
(length) (depth to top)
2", PVC
(size) (material)

(6) pump 1 hp., 9 1/2
(HP) (yield gpm)
Check.
(type power)

(7) electric log No
(yes or no)

(organization running log)

(8) how well bottom plugged
Backwash Valve

DRILLERS REMARKS:


DEPT. OF NATURAL RESOURCES
BUREAU OF LAND & WATER RESOURCES

APR 30 1984

RECEIVED

If well telescopes please sketch and show depths.

GROUND LEVEL

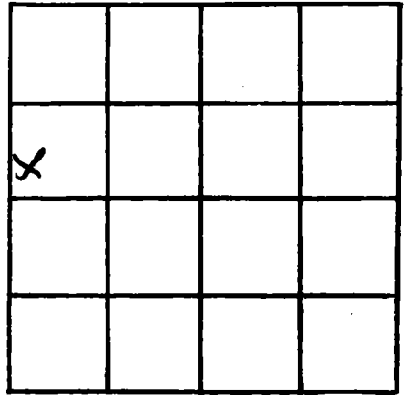

SECTION 36

Please indicate well location X.

ADDITIONAL INFORMATION

If more than one screen, show locations of ● on sketch.