

MISSISSIPPI DEPARTMENT OF NATURAL RESOURCES

Bureau of Land and Water Resources

Southport Mall

P.O. Box 10631

Jackson, Mississippi 39209

WATER WELL DRILLERS LOG

Jackson  
G 2048

5/3/84  
date well completed

FRYFOBLE WATER WELL  
firm name SERVICE

Jackson  
county well located

LANDOWNER: J.L. Haddon  
19108 Hwy 63  
Pascagoula MS 39567  
(mailing address)

description of formations encountered	depth	
	from	to
Topsoil + clay	0	15
SAND	15	100
Clay	100	255
SAND	255	260
CLAY	260	322
SAND	322	360

WELL LOCATION:  
sec. 10 T. 5 N R. 6 E  
1/8 miles N of Moss Point  
(distance) (direction) (nearest town)

WELL PURPOSE: Home  
(home, irrigation, municipal, industrial)

- WELL COMPLETION DATA:
- (1) diameter (inches) 2"
  - (2) total depth (feet) 360'
  - (3) static water level (feet) 7 <sup>below</sup> above top of ground.
  - (4) casing PVC, 360' (material), (depth)  
2" (size) if telescope see back.
  - (5) screen 5' (length), (depth to top)  
#6, PVC (size), (material)
  - (6) pump 3/4 (HP), 7 (yield gpm)  
ELEC (type power)
  - (7) electric log 20 (yes or no)  
(organization running log)
  - (8) how well bottom plugged good

DEPT. OF NATURAL RESOURCES  
BUREAU OF LAND & WATER RESOURCES


JUN 28 1984

RECEIVED

DRILLERS REMARKS:

If well telescopes please sketch and show depths.

GROUND LEVEL

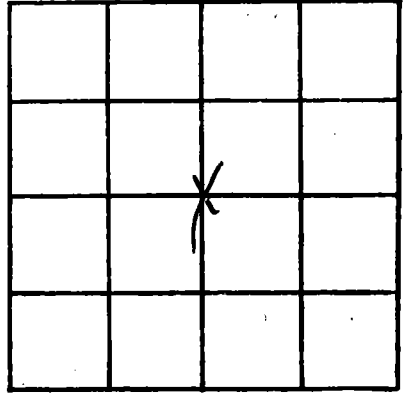

SECTION 1

Please indicate well location X.

ADDITIONAL INFORMATION

If more than one screen, show locations of each on sketch.