

MISSISSIPPI DEPARTMENT OF NATURAL RESOURCES

Bureau of Land and Water Resources

Southport Mall

P.O. Box 10631

Jackson, Mississippi 39209

WATER WELL DRILLERS LOG

G 2049
 JACKSON
 1-30-85

1-30-85 date well completed 19 Coast Water Well Sew. firm name Jackson county well located

LANDOWNER: Jack Smith
 Rt 5, Box 136,
 Pascagoula, Miss.
 (mailing address) 39567

WELL LOCATION:
 sec. 40, 5, 6 R. 6, 6 W. 5
 Wade
 (distance) miles (direction) of (nearest town)

WELL PURPOSE: Home
 (home, irrigation, municipal, industrial)

WELL COMPLETION DATA:

(1) diameter (inches) 2"

(2) total depth (feet) 430'

(3) static water level (feet) 20' below above top of ground

(4) casing PVC 410' (material) (depth)
 2" (size) if telescope see back.

(5) screen 20' 410' (length) (depth to top)
 2" (size) PVC (material)

(6) pump 1/2 HP 12 (HP) (yield gpm)
 Elect. (type power)

(7) electric log No (yes or no)

(organization running log)

description of formations encountered	from	to
Top soil	0	3'
Red Clay	3'	10'
Sand & pea gravel	10'	70'
Blue Clay	70'	125'
Sand (shaly clay)	125'	172'
White base sand	172'	193'
Blue Clay	193'	300'
Blue Clay & shell	300'	330'
Rock	330'	334'
Blue Clay w/ shell	334'	380'
Blue Clay	380'	405'
Coarse pebbles sand	405'	425'
Blue Clay	425'	430'
5' 3" PVC Tail Pipe		

RECEIVED
 APR 2 - 1985


(8) how well bottom plugged Backwash Valve

DRILLERS REMARKS:

Department of Natural Resources
 Bureau of Land & Water Resources

If well telescopes please sketch and show depths.

GROUND LEVEL

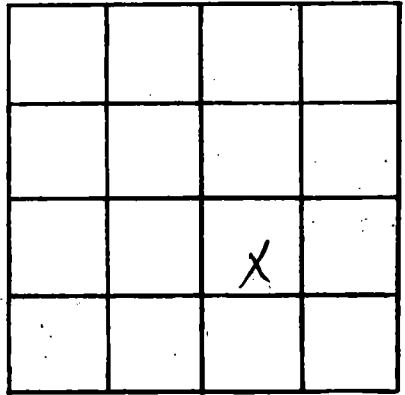

SECTION 42

Please indicate well location X.

ADDITIONAL INFORMATION

A series of horizontal lines for writing additional information, starting below the 'ADDITIONAL INFORMATION' header and extending to the bottom of the page.

If more than one screen, show locations of fish on sketch.