

Jackson
 6 20 SD
 5-23-85

MISSISSIPPI
 BOARD OF WATER COMMISSIONERS
 416 North State Street
 Jackson, Mississippi 39201

L

WATER WELL DRILLERS LOG

5-28 1985 Pierce Drilling Co Jackson
 date well completed firm name county well located

LANDOWNER: H. R. Bennette
 Dimheridge Rd
 Passagonala, Ms
 (mailing address)

description of formations encountered	from	to
200 soil	0	10
Clay + Sand	10	30
good Sand	30	80
Clay	80	150
good Sand	150	170

WELL LOCATION:
 sec 36 T-5 N R-5 E
 7 miles Southwest of Hurley
 (distance) (direction) (nearest town)

WELL PURPOSE:
 (home) irrigation, municipal, industrial

WELL COMPLETION DATA:
 (1) diameter (inches) 2"
 (2) total depth (feet) 170'
 (3) static water level (feet) 30' below top of ground.
 (4) casing plastic, 160' (material) (depth)
 0 (size) if telescope see back.
 (5) screen 10', 170' (length) (depth to top)
 006 plastic (size) (material)
 (6) pump 1 (HP) 12 (yield gpm)
 electric (type power)
 (7) electric log (yes or no)
 (organization running log)
 (8) how well bottom plugged BU


RECEIVED

JUL 23 1985

DRILLERS REMARKS:

If well telescopes please sketch and show depths.

GROUND LEVEL

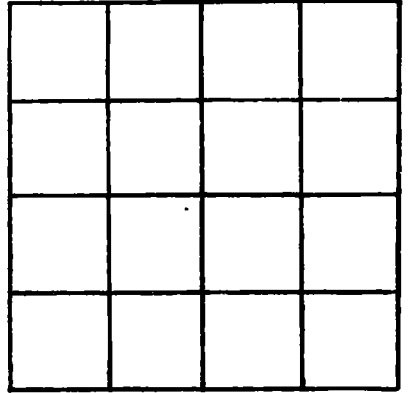

SECTION _____

Please indicate well location X.

ADDITIONAL INFORMATION

If more than one screen, show locations of each on sketch.