

MISSISSIPPI DEPARTMENT OF NATURAL RESOURCES

Bureau of Land and Water Resources

Southport Mall

P.O. Box 10631

Jackson, Mississippi 39209

WATER WELL DRILLERS LOG

Jackson
G 2051
6-10-85

L

6-10-85 date well completed 85 Coastal Water Well Dr. Jackson firm name county/well located

LANDOWNER

Chester B. Hutchens
3916 Lamphun Rd.
Pascagoula, Miss.
(mailing address) 39367

description of formations encountered

from to

| | | |
|--------------------------|-----|-----|
| Top soil | 0 | 1 |
| Red Med. sand | 1' | 15' |
| Red Coarse sand & Wood | 15' | 40' |
| Red Coarse sand | 40' | 70' |
| Red Coarse sand & gravel | 70' | 75' |
| 5' 2" PVC Tail Pipe | | |

WELL LOCATION:

sec 14 T 5 N R 6 E
2 miles SOUTH of WADSWORTH
(distance) (direction) (nearest town)

WELL PURPOSE:

None (home, irrigation, municipal, industrial)

WELL COMPLETION DATA:

- (1) diameter (inches) 2"
- (2) total depth (feet) 75'
- (3) static water level (feet) 18' below top of ground.
- (4) casing PVC, 65' (material) (depth)
2" (size) if telescope see back.
- (5) screen 10' 65' (length) (depth to top)
2" PVC (size) (material)
- (6) pump (HP) (yield gpm)
(type power)
- (7) electric log No (yes or no)
(organization running log)

(8) how well bottom plugged
Back Wash Valve

DRILLERS REMARKS:


RECEIVED

JUL 11 1985

Department of Natural Resources
Bureau of Land & Water Resources

If well telescopes please sketch and show depths.

GROUND LEVEL

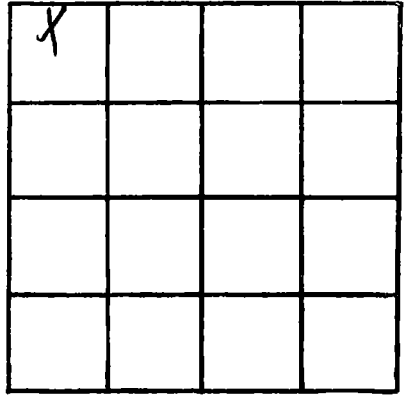

SECTION 14

Please indicate well location X.

ADDITIONAL INFORMATION

If more than one screen, show locations of each on sketch.