

JACKSON
 G 2052
 6-23-85

MISSISSIPPI
 BOARD OF WATER COMMISSIONERS
 416 North State Street
 Jackson, Mississippi 39201

L

WATER WELL DRILLERS LOG

6-23 1985 Pierce Drilling Jackson
 date well completed firm name county well located

LANDOWNER: Jerry Mathews
Timbersidge Rd
Pascagoula, MS
 (mailing address)

description of formations encountered	from	to
<u>top soil</u>	<u>0</u>	<u>10</u>
<u>Clay</u>	<u>10</u>	<u>45</u>
<u>good sand</u>	<u>45</u>	<u>60</u>

WELL LOCATION:
 sec. 36 T. 5 N. R. 6 E
3 W
4 miles West of Big Point
 (distance) (direction) (nearest town)

WELL PURPOSE:
 (home, irrigation, municipal, industrial)

- WELL COMPLETION DATA:
- diameter (inches) 2"
 - total depth (feet) 60'
 - static water level (feet) 20' below above top of ground.
 - casing plastic, 55'
 (material) (depth)
0 If telescope see back.
 (size)
 - screen 5', 60'
 (length) (depth to top)
006, plastic
 (size) (material)
 - pump 1 10
 (HP) (yield gpm)
electric
 (type power)
 - electric log (yes or no) _____
 (organization running log) _____
 - how well bottom plugged bu


RECEIVED
 JUL 23 1985

DRILLERS REMARKS:

Department of Natural Resources
 Bureau of Land & Water Resources

If well telescopes please sketch and show depths.

GROUND LEVEL

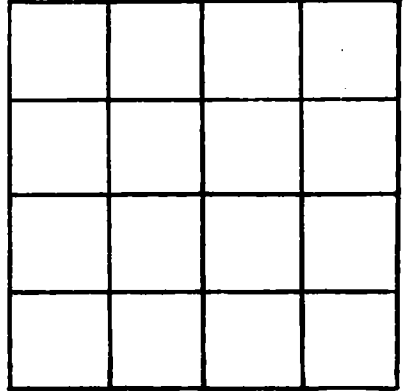

SECTION _____

Please indicate well location X.

ADDITIONAL INFORMATION

If more than one screen, show locations of each on sketch.