

MISSISSIPPI DEPARTMENT OF NATURAL RESOURCES

Bureau of Land and Water Resources

Southport Mall

P.O. Box 10631

Jackson, Mississippi 39209

WATER WELL DRILLERS LOG

JACKSON
G 2053

Aug. 22-85 19 Coast water well Jackson
date well completed firm name county well located

BANDOWNER: Ronny Blanton

Singon y Rivers Estate

(mailing address)

WELL LOCATION:

sec. 41 T. 5 N. R. 6 E.
6 miles NE of VANCELAKE
(distance) (direction) (nearest town)

WELL PURPOSE: home
(home, irrigation, municipal, industrial)

WELL COMPLETION DATA:

- (1) diameter (inches) 2"
 - (2) total depth (feet) 170'
 - (3) static water level (feet) 5 below above
top of ground.
 - (4) casing PVC, 154',
(material) (depth)
2"
(size) If telescope see back.
 - (5) screen 10', 154'
(length) (depth to top)
2" PVC
(size) (material)
 - (6) pump 1/2 hp, 8
(HP) (yield gpm)
Electric
(type power)
 - (7) electric log no
(yes or no)
- (organization running log)

(8) how well bottom plugged Backwash valve

DRILLERS REMARKS: 6' - 2" Tail Pipe

description of formations encountered	from	to
<u>Brown Coarse sand</u>	<u>0'</u>	<u>9'</u>
<u>Blue Clay</u>	<u>9'</u>	<u>15'</u>
<u>White Coarse Sand + Gravel</u>	<u>15'</u>	<u>60'</u>
<u>Streaks of Gravel + Blue Clay</u>	<u>60'</u>	<u>75'</u>
<u>Blue Clay</u>	<u>75'</u>	<u>115'</u>
<u>Streaks of Blue Clay - Sand</u>	<u>115'</u>	<u>128'</u>
<u>Grey Coarse Sand</u>	<u>128'</u>	<u>165'</u>
<u>Blue Clay</u>	<u>165'</u>	<u>170'</u>


RECEIVED

NOV - 4 1985

Department of Natural Resources
Bureau of Land & Water Resources

If well telescopes please sketch and show depths.

GROUND LEVEL

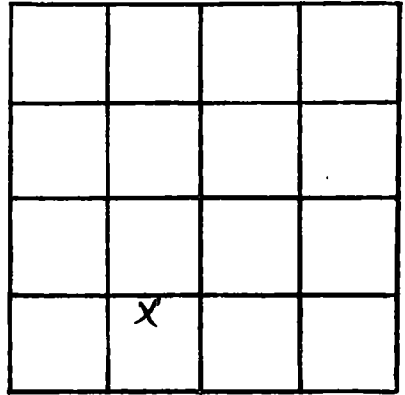

SECTION 41

Please indicate well location X.

ADDITIONAL INFORMATION

If more than one screen,
show locations of each on sketch.