

MISSISSIPPI DEPARTMENT OF NATURAL RESOURCES

Bureau of Land and Water Resources

Southport Mall

P.O. Box 10631

Jackson, Mississippi 39209

WATER WELL DRILLERS LOG

Jackson
G 7057P

8-28-88 19
date well completed

Coast Water Well Sew. Jackson
firm name county well located

LANDOWNER: Shane's Beauty Shop
13620 Wolf Ridge Rd.
Passapatanz, Miss.
(mailing address) 39567

| description of formations encountered | from | to |
|---------------------------------------|------|------|
| Red Clay | 0 | 14' |
| Black Mud Clay | 14' | 35' |
| Blue Clay | 35' | 47' |
| Red Coarse Sand & Gravel | 47' | 103' |
| Blue Clay & Sand | 103' | 120' |
| Blue Clay | 120' | 160' |
| Gray Mud. Sand & (Streaky) Clay | 160' | 185' |
| Blue Clay | 185' | 198' |
| Gray Mud. Sand | 198' | 218' |
| Blue Clay | 218' | 225' |
| 8" - 2" Tail Pipe | | |
| 2 1/2" | | |
| 1 1/2" | | |
| 1 1/2" | | |

WELL LOCATION:
sec. 7 T. 6 S. R. 86W
3 1/2 miles NW of HELENA
(distance) (direction) (nearest town)

WELL PURPOSE: home
(home, irrigation, municipal, industrial)

- WELL COMPLETION DATA:
- (1) diameter (inches) 2"
 - (2) total depth (feet) 225'
 - (3) static water level (feet) 30' (below/above top of ground)
 - (4) casing PVC 2 1/2"
(material) (depth)
2" If telescope see back.
(size)
 - (5) screen 10' 2 1/2"
(length) (depth to top)
2" PVC
(size) (material)
 - (6) pump _____
(HP) (yield gpm)

(type power)
 - (7) electric log _____
(yes or no)

(organization running log)
 - (8) how well bottom plugged
Stick Wash Valve

DRILLERS REMARKS: 8" - 2" Tail Pipe


RECEIVED

NOV - 4 1988

Department of Natural Resources
Bureau of Land & Water Resources

If well telescopes please sketch and show depths.

GROUND LEVEL

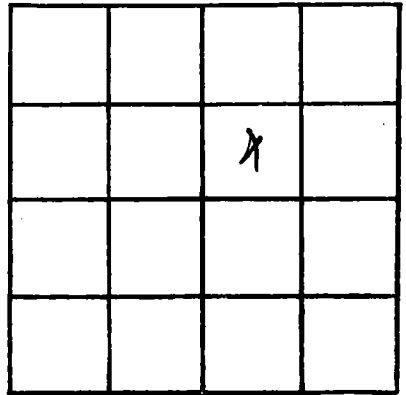

SECTION 7

Please indicate well location X.

ADDITIONAL INFORMATION

If more than one screen,
show locations of each on sketch.