

MISSISSIPPI DEPARTMENT OF NATURAL RESOURCES

Bureau of Land and Water Resources

Southport Mall

P.O. Box 10631

Jackson, Mississippi 39209

WATER WELL DRILLERS LOG

Jackson  
G  
7060

1-4-86 date well completed  
Perc Drilling Co firm name  
Jackson county well located

LANDOWNER: Mike Carter  
River Road  
Vanclaym S  
(mailing address)

description of formations encountered	from	to
top soil	0	20
Clay	20	30
gold Sand	30	60
Clay	60	220
gold Sand	220	260

WELL LOCATION:  
sec. 8 T. 5 N R. 6 E  
6 miles South of Wade  
(distance) (direction) (nearest town)

WELL PURPOSE:  
(home) Irrigation, municipal, Industrial

WELL COMPLETION DATA:

(1) diameter (inches) 2"

(2) total depth (feet) 260'

(3) static water level (feet) 100' below top of ground

(4) casing plastic 240'  
(material) (depth)

0 (size) if telescope see back.

(5) screen 10' 250'  
(length) (depth to top)

006 plastic  
(size) (material)

(6) pump 2 10  
(HP) (yield gpm)

electric  
(type power)

(7) electric log (yes or no)

(organization running log)

(8) how well bottom plugged BW


DRILLERS REMARKS:

RECEIVED  
FEB 12 1986

Department of Natural Resources  
Bureau of Land & Water Resources

If well telescopes please sketch and show depths.

GROUND LEVEL

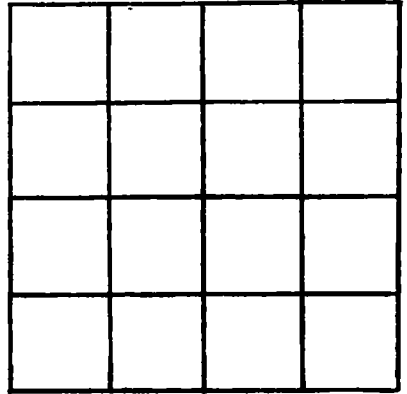

SECTION \_\_\_\_\_

Please indicate well location X.

**ADDITIONAL INFORMATION**

If more than one screen,  
show locations of each on sketch.