

MISSISSIPPI DEPARTMENT OF NATURAL RESOURCES

Bureau of Land and Water Resources

Southport Mall

P.O. Box 10631

Jackson, Mississippi 39209

WATER WELL DRILLERS LOG

Jackson
& 2061

Feb 4 - 1989, Coast water well Jackson
date well completed firm name county well located

LANDOWNER	Description of formations encountered	from	to
Spm Ruddy 4305 Knowlcrest Paragard mo 3985 (mailing address)	Top Soil	0	3
	Red Clay	3	18
WELL LOCATION: sec. 42-5 R. 6-6 5 miles SOUTH of WADE (distance) (direction) (nearest town)	Red Coral Sand + Gravel	16	68
WELL PURPOSE: Home (home, irrigation, municipal, industrial)	Blue Clay	68	127
WELL COMPLETION DATA: (1) diameter (inches) 2" (2) total depth (feet) 409 (3) static water level (feet) 44 below top of ground. (4) casing PVC 394' (material) (depth) 409 2" (size) If telescope see back. (5) screen 10' 394' (length) (depth to top) 31 2" (size) PVC (material) well 10 (6) pump 1/2 HP (type power) 9 (yield gpm) 40 Elex (7) electric log no (yes or no) (organization running log) (8) how well bottom plugged Backwash valve	White Coral Sand + Gravel	127	150
	Blue Clay	150	170
	White Coral Sand	170	197
	Blue Clay	197	330
	Rock	330	
	Gray med sand	330	333
	Blue Clay	333	390
	Gray Coral Sand	390	405
	Blue Clay	405	409


RECEIVED
MAR 7 1989

Department of Natural Resources
Bureau of Land & Water Resources

DRILLERS REMARKS:
5' 2" PVC tail pipe

If well telescopes please sketch and show depths.

GROUND LEVEL

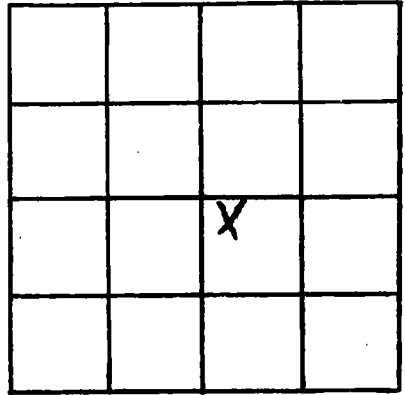

SECTION 42

Please indicate well location X.

ADDITIONAL INFORMATION

If more than one screen,
show locations of each on sketch.