

MISSISSIPPI DEPARTMENT OF NATURAL RESOURCES

Bureau of Land and Water Resources

Southport Mall

P.O. Box 10631

Jackson, Mississippi 39209

WATER WELL DRILLERS LOG

JACKSON
G 2062

1-31-86 date well completed 19 Coastwater well firm name Jackson county well located

LANDOWNER: Norma Goff
2616 Cypress Bluff Rd
Pascagoula, Miss
(mailing address) 39567

WELL LOCATION:
sec. 27 T 5 R 6
4 miles SOUTH of WADE
(distance) (direction) (nearest town)

WELL PURPOSE: home
(home, irrigation, municipal, industrial)

WELL COMPLETION DATA:

(1) diameter (inches) 4"

(2) total depth (feet) 140' Hole

(3) static water level (feet) 18 below above top of ground.

(4) casing PVC, 125'
(material), (depth)
4" if telescope see back.
(size) 140'
135' well

(5) screen 10', 125'
4" (length) (depth to top)
PVC
(size) (material)

(6) pump 1/2 HP, 20
(HP) (yield gpm)
Electric
(type power)

(7) electric log no
(yes or no)
Barwood valve
(organization running log)

(8) how well bottom plugged

description of formations encountered	from	to
cap sand	0	5
Red coarse sand + gravel	5	61
Blue clay	61	90
Gray coarse sand	90	135
Blue clay	135	140


RECEIVED
MAR 6 - 1986

DRILLERS REMARKS:
3 2" tailpipe

Department of Natural Resources
Bureau of Land & Water Resources

If well telescopes please sketch and show depths.

GROUND LEVEL

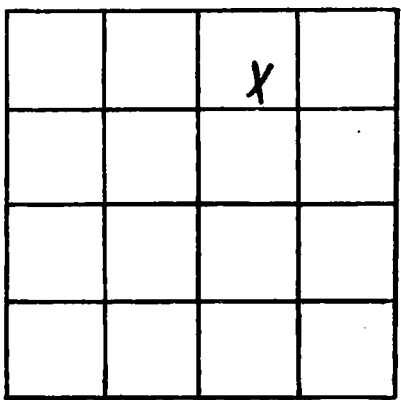

SECTION 27

Please indicate well location X.

ADDITIONAL INFORMATION

A series of horizontal lines for writing additional information, starting below the 'ADDITIONAL INFORMATION' header and extending to the bottom of the page.

If more than one screen, show locations of each on sketch.