

MISSISSIPPI DEPARTMENT OF NATURAL RESOURCES

Bureau of Land and Water Resources

Southport Mall

P.O. Box 10631

Jackson, Mississippi 39209

WATER WELL DRILLERS LOG

JACKSON
G 2064

3-20-86 date well completed 19 Coad water well firm name JACKSON county well located

LANDOWNER: Wade Black + wife
3311 market St
Pascagoula MS
(mailing address)

WELL LOCATION:
sec. 22 T 5 N R 6 E
S W

WELL PURPOSE: store - Hilda
(home, irrigation, municipal, industrial)

WELL COMPLETION DATA:

- (1) diameter (inches) 2"
- (2) total depth (feet) 300 1/4
- (3) static water level (feet) 65 below top of ground
- (4) casing PVC 275 (material), (depth)
- 2" (size) if telescope see back.
- (5) screen 10' 275' (length), (depth to top)
- 2" PVC (size), (material)
- (6) pump (HP) (yield gpm)
- (type power)
- (7) electric log no (yes or no)
- (organization running log)

(8) how well bottom plugged Backwash water

description of formations encountered	from	to
White Coarse Sand	0	48
Blue Clay	48	90
White Coarse Sand	90	120
Blue Clay	120	135
White Coarse Sand	135	185
Blue Clay	185	193
Gray Coarse Sand	193	300

well 275
10'
well 285


RECEIVED
JUL 18 1986

Department of Natural Resources
Bureau of Land & Water Resources

DRILLERS REMARKS:
15' - 2" PVC
tail pipe

If well telescopes please sketch and show depths.

GROUND LEVEL

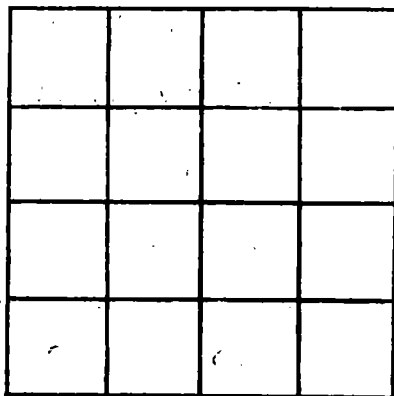

SECTION _____

Please indicate well location X.

ADDITIONAL INFORMATION

If more than one screen, show locations of each on sketch.