

MISSISSIPPI DEPARTMENT OF NATURAL RESOURCES

Bureau of Land and Water Resources

Southport Mall

P.O. Box 10631

Jackson, Mississippi 39209

WATER WELL DRILLERS LOG


JACKSON
G 2066

9-9 1986 De Purce Drilling Co. Jackson
date well completed firm name county well located

| LANDOWNER: <u>David Larsen</u> | description of formations encountered | from | to |
|--|---|-----------|-----------|
| <u>PO Box 1</u> | <u>Top Soil</u> | <u>0</u> | <u>10</u> |
| <u>Pascagoula Ms</u> (mailing address) | <u>Sand & Clay</u> | <u>10</u> | <u>20</u> |
| WELL LOCATION: sec. <u>22</u> T <u>5</u> N R <u>6</u> E <u>1</u> miles <u>West</u> of <u>3 Rivers</u> (distance) (direction) (nearest town) | <u>good Sand</u> | <u>20</u> | <u>65</u> |
| WELL PURPOSE: (home, irrigation, municipal, industrial) | | | |
| WELL COMPLETION DATA: (1) diameter (inches) <u>2"</u> (2) total depth (feet) <u>65'</u> (3) static water level (feet) <u>20'</u> <u>below</u> above top of ground. (4) casing <u>plastic</u> , <u>60'</u> (material) (depth) <u>0</u> if telescope see back. (size) (5) screen <u>5'</u> , <u>65'</u> (length) (depth to top) <u>006</u> , <u>plastic</u> (size) (material) (6) pump <u>1</u> , <u>12</u> (HP) (yield gpm) <u>electric</u> (type power) (7) electric log <u>yes</u> (yes or no) (organization running log) (8) how well bottom plugged <u>BW</u> | <p style="text-align: center;">RECEIVED</p> <p style="text-align: center;">OCT 15 1986</p> <p style="text-align: center;">Department of Natural Resources Bureau of Land & Water Resources</p> | | |
| DRILLERS REMARKS: | | | |

If well telescopes please sketch and show depths.

GROUND LEVEL

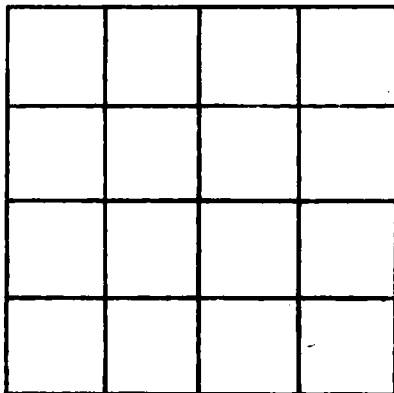

SECTION _____

Please indicate well location X.

ADDITIONAL INFORMATION

If more than one screen, show locations of each on sketch.