

MISSISSIPPI DEPARTMENT OF NATURAL RESOURCES

Bureau of Land and Water Resources

Southport Mall

P.O. Box 10631

Jackson, Mississippi 39209

WATER WELL DRILLERS LOG

JACKSON
G 2069

9-27 1986 Sp Pierce Drilling Co Jackson
 date well completed firm name county well located

LANDOWNER: Olava Moffett
Three Rivers
Pascagoula Ms
 (mailing address)

description of formations encountered	from	to
200 Soil	0	10
Sand & Clay	10	20
Clay	20	30
gravel Sand	30	65

WELL LOCATION:
 sec 26 T 5 N R 6 E
 (S) (W)
1 miles South of 3-Rivers
 (distance) (direction) (nearest town)

WELL PURPOSE:
 (home, irrigation, municipal, industrial)

- WELL COMPLETION DATA:
- (1) diameter (inches) 2"
 - (2) total depth (feet) 65'
 - (3) static water level (feet) 20' below above top of ground.
 - (4) casing plastic, 60'
 (material) (depth)
 - 0 If telescope see back.
 (size)
 - (5) screen 5', 65'
 (length) (depth to top)
 - 006, plastic
 (size) (material)
 - (6) pump 1/2, 8
 (HP) (yield gpm)
 - electric
 (type power)
 - (7) electric log (yes or no)

(organization running log)
 (8) how well bottom plugged BW

DRILLERS REMARKS:


RECEIVED

OCT 15 1986

Department of Natural Resources
 Bureau of Land & Water Resources

If well telescopes please sketch and show depths.

GROUND LEVEL

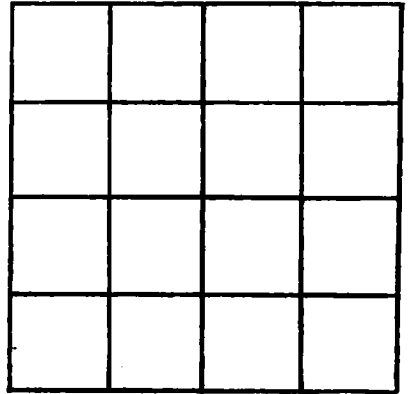

SECTION _____

Please indicate well location X.

ADDITIONAL INFORMATION

If more than one screen, show locations of each on sketch.