

MISSISSIPPI DEPARTMENT OF NATURAL RESOURCES

Bureau of Land and Water Resources

Southport Mall

P.O. Box 10631

Jackson, Mississippi 39209

WATER WELL DRILLERS LOG

JACKSON
G 2068

1-2 1980 Price Drilling Co. Jackson
date well completed firm name county well located

LANDOWNER: Beryl Stringfellow
Three Rivers
Pascagoula, MS
(mailing address)


Description of formations encountered	from	to
Top soil	0	10
Clay	10	30
good sand	30	100
clay	100	140
good sand	140	160

WELL LOCATION:
sec. 1 T. 5 N. R. 6 E.
5 miles SW of Big Point
(distance) (direction) (nearest town)

WELL PURPOSE:
(home, irrigation, municipal, industrial)

- WELL COMPLETION DATA:
- (1) diameter (inches) 2"
 - (2) total depth (feet) 160'
 - (3) static water level (feet) 30' ^{below} above top of ground.
 - (4) casing plastic, 155' (material) (depth)
0 (size) If telescope see back.
 - (5) screen 5' (length), 160' (depth to top)
006, plastic (size) (material)
 - (6) pump 1/2 (HP), 6 (yield gpm)
electric (type power)
 - (7) electric log (yes or no)
 - (organization running log)
 - (8) how well bottom plugged BW

DRILLERS REMARKS:

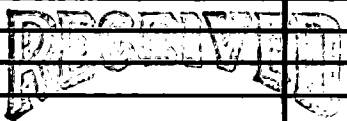


SEP 15 1987

Department of Natural Resources
Bureau of Land & Water Resources

If well telescopes please sketch and show depths.

GROUND LEVEL

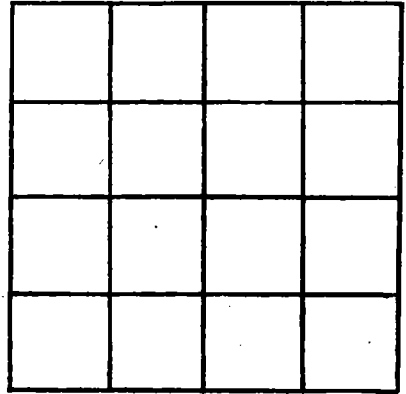

SECTION _____

Please indicate well location X.

ADDITIONAL INFORMATION

If more than one screen,
show locations of each on sketch.