

MISSISSIPPI DEPARTMENT OF NATURAL RESOURCES

Bureau of Land and Water Resources

Southport Mall

P.O. Box 10631

Jackson, Mississippi 39209

WATER WELL DRILLERS LOG

Jackson
G 2069

3-4 1987 date well completed Pierce Drilling Co. firm name Jackson county well located

LANDOWNER <u>Jammy Smith</u>	description of formations encountered	from	to
<u>Pascagoula, ms</u> (mailing address)	<u>top soil</u>	0	10
	<u>clay</u>	10	20
	<u>good sand</u>	20	48
WELL LOCATION: sec. <u>3</u> T <u>5</u> N R <u>6</u> E <u>1</u> miles <u>South</u> of <u>Wade</u> (distance) (direction) (nearest town)			
WELL PURPOSE: <u>(home, irrigation, municipal, industrial)</u>			
WELL COMPLETION DATA:			
(1) diameter (inches) <u>2"</u>			
(2) total depth (feet) <u>48'</u>			
(3) static water level (feet) <u>15'</u> <u>below</u> above top of ground.			
(4) casing <u>plastic</u> , <u>43</u> (material) (depth)			
<u>0</u> If telescope see back. (size)			
(5) screen <u>5'</u> , <u>48'</u> (length) (depth to top)			
<u>006</u> , <u>plastic</u> (size) (material)			
(6) pump <u>1</u> <u>12</u> (HP) (yield gpm)			
<u>electric</u> (type power)			
(7) electric log <u>(yes or no)</u>			
<u>(organization running log)</u>			
(8) how well bottom plugged <u>BW</u>			
DRILLERS REMARKS:			


RECEIVED

SEP 15 1987

Department of Natural Resources
Bureau of Land & Water Resources

If well telescopes please sketch and show depths.

GROUND LEVEL

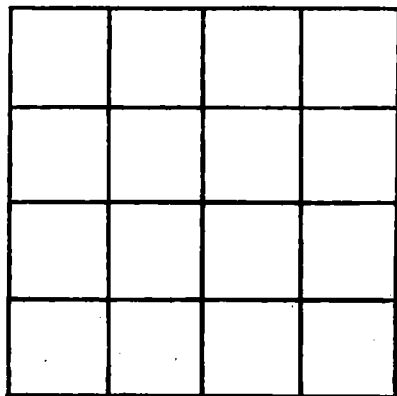

SECTION _____

Please indicate well location X.

ADDITIONAL INFORMATION

If more than one screen,
show locations of each on sketch.