

MISSISSIPPI DEPARTMENT OF NATURAL RESOURCES

Bureau of Land and Water Resources

Southport Mall

P.O. Box 10631

Jackson, Mississippi 39209

WATER WELL DRILLERS LOG

Jackson  
G 2070

4-5 1987 date well completed  
Purci Drilling Co firm name  
Jackson county well located

LANDOWNER: Paul Watson	description of formations encountered	from	to
Passagoula, Ms (mailing address)	Top Soil	0	10
WELL LOCATION: sec. 27 T 5 N R 6 E 1 miles South of 3-Rivers (distance) (direction) (nearest town)	Clay	10	20
WELL PURPOSE: (home) Irrigation, municipal, industrial	Sand	20	45
WELL COMPLETION DATA: (1) diameter (inches) 2"	Clay	45	55
(2) total depth (feet) 75'	Good Sand	55	75
(3) static water level (feet) 10' below top of ground.			
(4) casing plastic, 70' (material) (depth)			
(5) screen 5' length, 75' depth, to top			
(6) pump 1 (HP), 15 (yield gpm)			
(7) electric log (yes or no)			
(8) how well bottom plugged BW			
DRILLERS REMARKS:			


RECEIVED

SEP 15 1987

Department of Natural Resources  
Bureau of Land & Water Resources

If well telescopes please sketch and show depths.

GROUND LEVEL

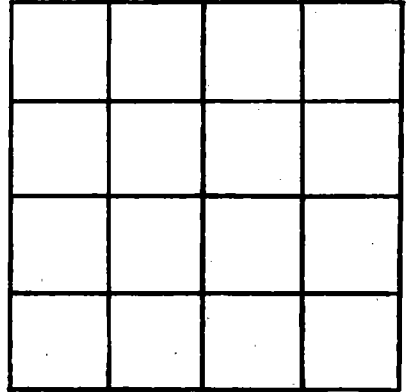

SECTION \_\_\_\_\_

Please indicate well location X.

ADDITIONAL INFORMATION

If more than one screen, show locations of each on sketch.