

MISSISSIPPI DEPARTMENT OF NATURAL RESOURCES

Bureau of Land and Water Resources

Southport Mall

P.O. Box 10631

Jackson, Mississippi 39209

WATER WELL DRILLERS LOG

JACKSON
G 2072

7-6 1987 Pierce Drilling Co. Jackson
date well completed firm name county well located

LANDOWNER: Rodney Kerkeford

3025 Big Point Rd.

Pascagoula, MS
(mailing address)

description of formations encountered

from

to

top soil

0 10

Clay

10 20

good sand

20 35

WELL LOCATION:

sec. 31 T-5 N R-6 E
2 miles West of Wade
(distance) (direction) (nearest town)

WELL PURPOSE:


(home) Irrigation, municipal, industrial

WELL COMPLETION DATA:

- (1) diameter (inches) 2"
- (2) total depth (feet) 35'
- (3) static water level (feet) 20' below top of ground
- (4) casing plastic, 30' (material) (depth)
- 0 (size) If telescope see back.
- (5) screen 5' length, 35' depth to top
- 000 plastic (size) (material)
- (6) pump 1 (HP), 12 (yield gpm)
- electric (type power)
- (7) electric log (yes or no)

(organization running log)

(8) how well bottom plugged BW

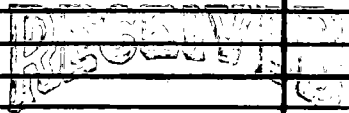


SEP 15 1987

Department of Natural Resources
Bureau of Land & Water Resources

DRILLERS REMARKS:

If well telescopes please sketch and show depths.

GROUND LEVEL

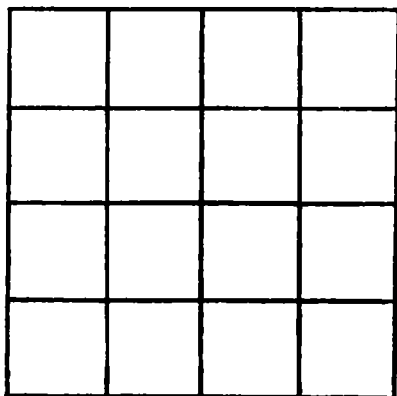

SECTION _____

Please indicate well location X.

ADDITIONAL INFORMATION

If more than one screen, show locations of each on sketch.