

# MISSISSIPPI DEPARTMENT OF NATURAL RESOURCES

Bureau of Land and Water Resources

P.O. Box 10631

Jackson, Mississippi 39209

WATER WELL DRILLERS LOG

COUNTY WELL LOCATED	
<b>JACKSON</b>	
WELL NUMBER	CODED
G-2077	
DATE WELL COMPLETED	
4-22-88	

PERMIT NUMBER
NAME OF DRILLING FIRM
<b>COAST WATER</b>
<b>WELL SVC</b>

NAME & MAILING ADDRESS OF LANDOWNER			
<b>Chester Hutchens</b>			
<b>34279 Davis Rd</b>			
<b>Pascagoula ms.</b>			
WELL LOCATION:	SEC	TOWNSHIP	RANGE
	11	5	N 16 E
DISTANCE	DIRECTION	NEAREST TOWN	
2	SE	of WADE	
OTHER LANDMARK			
WELL PURPOSE: Home, Irrigation, Municipal, Industrial, Fish Pond, etc.			
<b>home</b>			

PUMP DATA		
PUMP TYPE (Circle One):		
<input type="checkbox"/> Submersible,	<input type="checkbox"/> Turbine,	<input type="checkbox"/> Jet
Flowing Well,		
Other (Describe) _____		
POWER TYPE (Circle One):		
<input type="checkbox"/> Electric,	<input type="checkbox"/> Tractor,	<input type="checkbox"/> Diesel,
<input type="checkbox"/> Gasoline,	<input type="checkbox"/> Butane,	
Other (Describe) _____		
Pump Capacity (GPM)	No. of Stages	Setting Depth
		FT.
PUMP TEST		
Well yielded _____ GPM with		
a drawdown of _____ ft.		
after _____ hours of pumping		

WELL DATA		
Well Depth	Casing Diameter (In.)	Casing Length (Ft.)
385'	2"	376'
Type of Casing	Hole Depth	Depth to Static Water Level
PVC	385'	17'
TYPE OF COMPLETION: (Circle One or More):		
<input checked="" type="checkbox"/> Gravel Packed,	<input type="checkbox"/> Underreamed,	<input type="checkbox"/> Telescoped,
<input checked="" type="checkbox"/> Natural Development,	<input type="checkbox"/> Open Hole,	<input type="checkbox"/> Other
(Describe) _____		
Top of Lap Pipe or Reduction in Casing		
FEET	IF TELESCOPED OR MORE THAN ONE SCREEN: USE BACK PAGE	

LOG DATA	
TYPE OF LOG RUN (Circle One):	
<input type="checkbox"/> Electric,	<input type="checkbox"/> Gamma Ray,
<input type="checkbox"/> Density,	<input type="checkbox"/> Sonic,
<input type="checkbox"/> Neutron,	<input checked="" type="checkbox"/> No Log Run,
Other (Describe) _____	
Name of Organization Running Log	

SCREEN DATA		
Diameter - Inches	Length - Feet	Slot Size - Inches
2"	9'	.008
Screen Type	Depth to Bottom - Feet	
PVC	385'	

GEOLOGIC DATA (Office Use Only)			
Surface Elev.	Geologic Unit	Unit Thickness	Depth to Top
Subs. SWL	Date	Analysis	Aquifer Test

Driller's Remarks
-------------------

RECEIVED

DESCRIPTION OF FORMATIONS ENCOUNTERED	FROM	TO	FORMATIONS (continued)	FROM	TO
TOP SOIL	0	2			
WHITE COARSE SAND	2	17			
BLUE CLAY	17	33			
GRAY COARSE SAND & GRAVEL	33	90			
BLUE CLAY	90	224			
GRAY MGD SAND	224	239			
BLUE CLAY	239	375			
GRAY MGD SAND	375	385			


MAY 24 1988

Department of Natural Resources  
Bureau of Land & Water Resources

IF MORE SPACE IS NEEDED, USE BACK

If well telescopes please sketch and show depths.

GROUND LEVEL

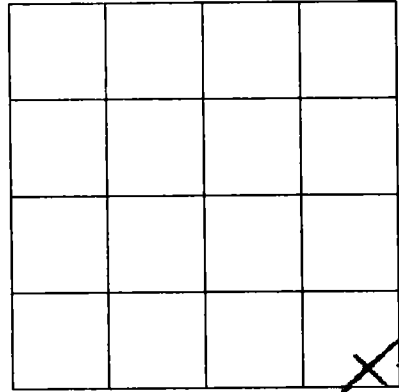

SECTION 11

Please indicate well location X.

ADDITIONAL INFORMATION

If more than one screen,  
show location of each on sketch.