

**MISSISSIPPI DEPARTMENT OF NATURAL RESOURCES**  
Bureau of Land and Water Resources

P.O. Box 10631  
Jackson, Mississippi 39209  
**WATER WELL DRILLERS LOG**

COUNTY WELL LOCATED <b>Jackson</b>	
WELL NUMBER <b>G2087</b>	CODE
DATE WELL COMPLETED <b>10-26-88</b>	

PERMIT NUMBER
NAME OF DRILLING FIRM <b>Coastwater Well Service</b>

NAME & MAILING ADDRESS OF LANDOWNER <b>Paul Leonard</b>			
<b>Fish Lake Road</b>			
<b>Pascagoula MS</b>			
WELL LOCATION:	SEC	TOWNSHIP	RANGE
	<b>18</b>	<b>5</b>	<b>6</b>
DISTANCE	DIRECTION	NEAREST TOWN	
<b>4</b> Miles	<b>SW</b>	of <b>Wade</b>	
OTHER LANDMARK			
WELL PURPOSE: Home, Irrigation, Municipal, Industrial, Fish Pond, etc. <b>home</b>			


<b>PUMP DATA</b>		
PUMP TYPE (Circle One): Submersible, Turbine, Jet, <u>Flowing Well</u> , Other (Describe) _____		
POWER TYPE (Circle One): Electric, Tractor, Diesel, Gasoline, Butane, Other (Describe) _____		
Pump Capacity (GPM)	No. of Stages	Setting Depth
		FT.
PUMP TEST <b>None</b>		
Well yielded _____ GPM with a drawdown of _____ ft. after _____ hours of pumping		

<b>WELL DATA</b>		
Well Depth <b>135</b>	Casing Diameter (In.) <b>2"</b>	Casing Length (Ft.) <b>150</b>
Type of Casing <b>PVC</b>	Hole Depth <b>135'</b>	Depth to Static Water Level <b>7'</b>
TYPE OF COMPLETION: (Circle One or More): <u>Gravel Packed</u> , Underreamed, Telescoped, Natural Development, Open Hole, Other (Describe) _____		
Top of Lap Pipe or Reduction in Casing		
FEET	IF TELESCOPED OR MORE THAN ONE SCREEN: USE BACK PAGE	

<b>LOG DATA</b>	
TYPE OF LOG RUN (Circle One): Electric, Gamma Ray, Density, Sonic, Neutron, Other (Describe) _____	
<u>No Log Run</u>	
Name of Organization Running Log	

<b>SCREEN DATA</b>		
Diameter - Inches <b>2"</b>	Length - Feet <b>10'</b>	Slot Size - Inches <b>.008</b>
Screen Type <b>PVC</b>	Depth to Bottom - Feet <b>130'</b>	


<b>GEOLOGIC DATA (Office Use Only)</b>			
Surface Elev.	Geologic Unit	Unit Thickness	Depth to Top
Subs. SWL	Date	Analysis	Aquifer Test
Driller's Remarks			

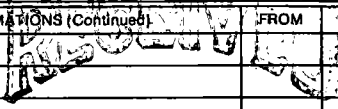DESCRIPTION OF FORMATIONS ENCOUNTERED	FROM	TO	FORMATIONS (Continued)	FROM	TO
<b>Brown Clay</b>	<b>0</b>	<b>12</b>	  <b>NOV 15 1988</b>  Department of Natural Resources Bureau of Land & Water Resources		
<b>Blue Clay</b>	<b>12</b>	<b>28</b>			
<b>White Coarse Sand + Gravel</b>	<b>28</b>	<b>44</b>			
<b>Blue Clay</b>	<b>44</b>	<b>90</b>			
<b>Gray Coarse Sand</b>	<b>90</b>	<b>130</b>			
<b>Blue Clay</b>	<b>130</b>	<b>135</b>			

IF MORE SPACE IS NEEDED, USE BACK

If well telescopes please sketch and show depths.

GROUND LEVEL

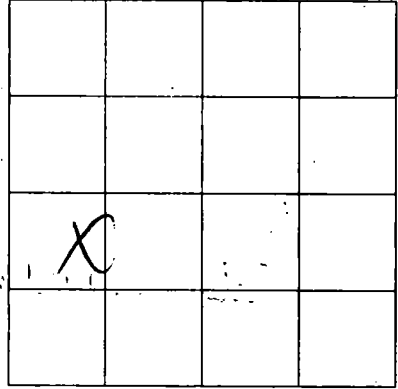

SECTION 18

Please indicate well location X.

ADDITIONAL INFORMATION

Lined area for additional information.

If more than one screen, show location of each on sketch.